

MISSISSIPPI DEPARTMENT OF NATURAL RESOURCES

Bureau of Land and Water Resources

Southport Mall

P.O. Box 10631

Jackson, Mississippi 39209

WATER WELL DRILLERS LOG

Hancock
K Hebr

Sept. 11 1986 Ward Well Drg. Hancock
 date well completed firm name county well located

LANDOWNER: John Don Garcia
Rt. 5, Box 428 D
Bay St. Louis, ms.
 (mailing address)

description of formations encountered	from	to
<u>Sandy Silt-clay</u>	<u>0</u>	<u>12</u>
<u>Clay</u>	<u>12</u>	<u>44</u>
<u>Clay</u>	<u>44</u>	<u>96</u>
<u>Red gravel - sd</u>	<u>96</u>	<u>125</u>
<u>Clay - silt</u>	<u>125</u>	<u>230</u>
<u>Coarse sd</u>	<u>230</u>	<u>262</u>

WELL LOCATION:
 sec. 26 T 9 N R 14 E
12 miles W of Woodland
 (distance) (direction) (nearest town)

WELL PURPOSE: Home
 (home, irrigation, municipal, industrial)

WELL COMPLETION DATA:

- (1) diameter (inches) 2"
- (2) total depth (feet) 262'
- (3) static water level (feet) 10 ^{below}/_{above} top of ground.
- (4) casing PVC, 252'
 (material) (depth)
 (size) if telescope see back.
- (5) screen 10', -
 (length) (depth to top)
2", PVC
 (size) (material)
- (6) pump owner, -
 (HP) (yield gpm)
 (type power)
- (7) electric log NO
 (yes or no)
N/A
 (organization running log)
- (8) how well bottom plugged BWV

RECEIVED


NOV 14 1986

Department of Natural Resources
 Bureau of Land & Water Resources

DRILLERS REMARKS: N/A

If well telescopes please sketch and show depths.

GROUND LEVEL

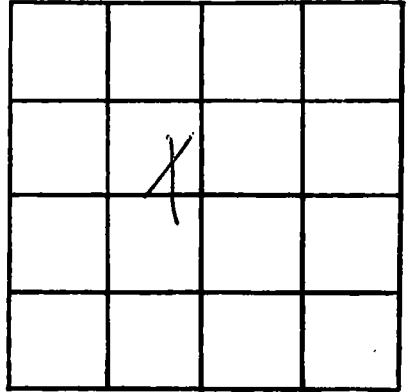

SECTION 2B

Please indicate well location X.

ADDITIONAL INFORMATION

If more than one screen,
show locations of each on sketch.