

MISSISSIPPI DEPARTMENT OF NATURAL RESOURCES

Bureau of Land and Water Resources

Southport Mall

P.O. Box 10631

Jackson, Mississippi 39209

WATER WELL DRILLERS LOG

Hancock  
K 2670

Sept. 16 1986 Ward Wells Hancock  
date well completed firm name county well located


LANDOWNER: Jimmie Brown  
Ave. B & 3rd St.  
Bay St. Louis ms.  
(mailing address)

description of formations encountered	from	to
<u>Sand Soil</u>	<u>0</u>	<u>3</u>
<u>Clay</u>	<u>3</u>	<u>14</u>
<u>SD</u>	<u>14</u>	<u>47</u>
<u>Clay-silt</u>	<u>47</u>	<u>105</u>
<u>fine sd</u>	<u>105</u>	<u>122</u>
<u>Clay-silt</u>	<u>122</u>	<u>164</u>
<u>SD</u>	<u>164</u>	<u>180</u>

WELL LOCATION:  
sec. 28 T 8 N R 14 E  
5 miles N/W of B.S.L.  
(distance) (direction) (nearest town)

WELL PURPOSE: Home  
(home, irrigation, municipal, industrial)

- WELL COMPLETION DATA:
- (1) diameter (inches) 2"
  - (2) total depth (feet) 180
  - (3) static water level (feet) 8 below above top of ground.
  - (4) casing PVC 170  
(material) (depth)
  - (size) If telescope see back.
  - (5) screen 10' -  
(length) (depth to top)
  - 2" PVC  
(size) (material)
  - (6) pump owner -  
(HP) (yield gpm)
  - (type power)
  - (7) electric log NO  
(yes or no)
  - (organization running log) N/A
  - (8) how well bottom plugged BWW

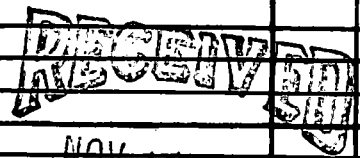


NOV 14 1986

Department of Natural Resources  
Bureau of Land & Water Resources

DRILLERS REMARKS: N/A

If well telescopes please sketch and show depths.

GROUND LEVEL

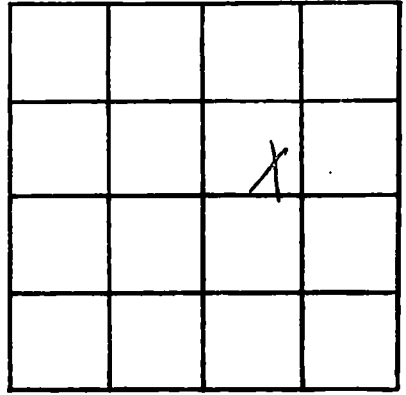

SECTION 28

Please indicate well location X.

ADDITIONAL INFORMATION

If more than one screen, show locations of each on sketch.