

Hancock  
K 2672

MISSISSIPPI DEPARTMENT OF NATURAL RESOURCES  
 Bureau of Land and Water Resources  
 Southport Mall  
 P.O. Box 10631  
 Jackson, Mississippi 39209  
**WATER WELL DRILLERS LOG**

Sept. 24 1986 Wood Well Dr. Hancock  
 date well completed firm name county well located


LANDOWNER: Charles Dentler  
1st St.  
Bay St. Louis mo.  
 (mailing address)

description of formations encountered	from	to
<u>fill - clay</u>	<u>0</u>	<u>18</u>
<u>clay - silt</u>	<u>18</u>	<u>48</u>
<u>clay - silt</u>	<u>48</u>	<u>96</u>
<u>clay - silt</u>	<u>96</u>	<u>115</u>
<u>sd</u>	<u>115</u>	<u>166</u>
<u>sd</u>	<u>166</u>	<u>190</u>

WELL LOCATION:  
 sec. 40 T 8 N R 12 E  
7 miles NW of Dawson  
 (distance) (direction) (nearest town)

WELL PURPOSE: Home  
 (home, irrigation, municipal, industrial)

- WELL COMPLETION DATA:
- (1) diameter (inches) 2"
  - (2) total depth (feet) 190
  - (3) static water level (feet) 8 below above top of ground.
  - (4) casing PVC, 180  
 (material), (depth)  
— if telescope see back.  
 (size)
  - (5) screen 10', —  
 (length), (depth to top)  
2", PVC  
 (size), (material)
  - (6) pump owner, —  
 (HP), (yield gpm)  
—  
 (type power)
  - (7) electric log NO  
 (yes or no)  
N/A  
 (organization running log)
  - (8) how well bottom plugged BWV

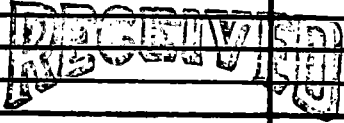


NOV 14 1986

Department of Natural Resources  
 Bureau of Land & Water Resources

DRILLERS REMARKS: N/A

If well telescopes please sketch and show depths.

GROUND LEVEL

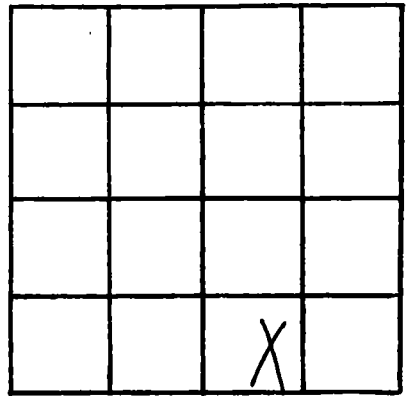

SECTION 40

Please indicate well location X.

ADDITIONAL INFORMATION

If more than one screen, show locations of each on sketch.