

MISSISSIPPI DEPARTMENT OF NATURAL RESOURCES

Bureau of Land and Water Resources

Southport Mall

P.O. Box 10631

Jackson, Mississippi 39209

WATER WELL DRILLERS LOG

Hancock  
K 2673

Sept. 29 1986 Ward Well Drg Hancock  
date well completed firm name county well located

LANDOWNER: Kera S. Damien  
P.O. Box 184  
Clermont Harbor, ms.  
(mailing address)

WELL LOCATION:  
sec. 17 T 8 N R 14 E  
8 miles W of Ward  
(distance) (direction) (nearest town)

WELL PURPOSE: Home  
(home, irrigation, municipal, industrial)

- WELL COMPLETION DATA:
- (1) diameter (inches) 2"
  - (2) total depth (feet) 315
  - (3) static water level (feet) 12 below above top of ground.
  - (4) casing PVC, 305,  
(material) (depth)  
- if telescope see back.  
(size)
  - (5) screen 10', -  
(length) (depth to top)  
2", PVC  
(size) (material)
  - (6) pump 1/2, 10  
(HP) (yield gpm)  
Elec.  
(type power)
  - (7) electric log NO  
(yes or no)  
N/A  
(organization running log)
  - (8) how well bottom plugged BWV

description of formations encountered	from	to
<u>clay</u>	<u>0</u>	<u>14</u>
<u>sd</u>	<u>14</u>	<u>52</u>
<u>clay-silt</u>	<u>52</u>	<u>106</u>
<u>Red gravel-sd</u>	<u>106</u>	<u>130</u>
<u>clay-silt</u>	<u>130</u>	<u>210</u>
<u>fine sd</u>	<u>210</u>	<u>230</u>
<u>clay-silt</u>	<u>230</u>	<u>275</u>
<u>coarse sd</u>	<u>275</u>	<u>315</u>

**RECEIVED**


NOV 14 1986

Department of Natural Resources  
Bureau of Land & Water Resources

DRILLERS REMARKS: N/A

If well telescopes please sketch and show depths.

GROUND LEVEL

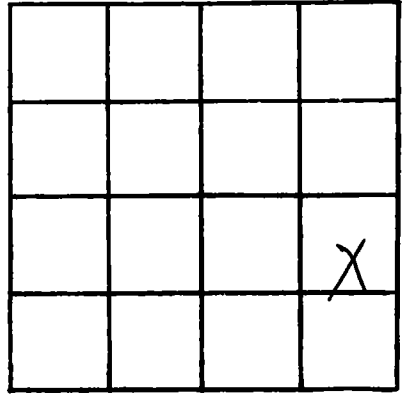

SECTION 17

Please indicate well location X.

**ADDITIONAL INFORMATION**

A series of horizontal lines for writing additional information.

If more than one screen, show locations of each on sketch.