

MISSISSIPPI DEPARTMENT OF NATURAL RESOURCES
Bureau of Land and Water Resources

P.O. Box 10631
Jackson, Mississippi 39209
WATER WELL DRILLERS LOG

COUNTY WELL LOCATED <u>Hancock</u>
WELL NUMBER CODED <u>R 2675</u>
DATE WELL COMPLETED <u>Oct. 11, 1986</u>

PERMIT NUMBER
NAME OF DRILLING FIRM <u>McMillan Pump Service</u>

NAME & MAILING ADDRESS OF LANDOWNER <u>M. J. Saperstein</u> <u>1200 ... St.</u> <u>...</u>		
WELL LOCATION: SEC	TOWNSHIP	RANGE
	<u>N</u>	<u>E</u>
	<u>S</u>	<u>W</u>
DISTANCE	DIRECTION	NEAREST TOWN
<u>3</u> Miles	<u>West</u> of <u>...</u>	
OTHER LANDMARK		
WELL PURPOSE: Home, Irrigation, Municipal, Industrial, Fish Pond, etc. <u>Fence</u>		

PUMP DATA		
PUMP TYPE (Circle One): Submersible, Turbine, Jet, Flowing Well, Other (Describe) <u>WELL CAP</u>		
POWER TYPE (Circle One): Electric, Tractor, Diesel, Gasoline, Butane, Other (Describe) <u>...</u>		
Pump Capacity (GPM)	No. of Stages	Setting Depth FT.
PUMP TEST		
Well yielded <u>15</u> GPM with a drawdown of <u>5</u> ft. after <u>1</u> hours of pumping		

WELL DATA		
Well Depth <u>330'</u>	Casing Diameter (In.) <u>2"</u>	Casing Length (Ft.) <u>370'</u>
Type of Casing <u>PVC</u>	Hole Depth <u>290'</u>	Depth to Static Water Level <u>5'</u>
TYPE OF COMPLETION: (Circle One or More): <input checked="" type="checkbox"/> Gravel Packed, <input type="checkbox"/> Underreamed, <input type="checkbox"/> Telescoped, <input checked="" type="checkbox"/> (Natural Development), <input type="checkbox"/> Open Hole, <input type="checkbox"/> Other (Describe)		
Top of Lap Pipe or Reduction in Casing FEET <input type="checkbox"/> IF TELESCOPED OR MORE THAN ONE SCREEN: USE BACK PAGE		

LOG DATA	
TYPE OF LOG RUN (Circle One): Electric, Gamma Ray, Density, Sonic, Neutron, Other (Describe) <input checked="" type="checkbox"/> No Log Run	
Name of Organization Running Log	

SCREEN DATA		
Diameter - Inches <u>2"</u>	Length - Feet <u>10'</u>	Slot Size - Inches <u>6/32</u>
Screen Type <u>PVC</u>	Depth to Bottom - Feet <u>280'</u>	


GEOLOGIC DATA (Office Use Only)			
Surface Elev.	Geologic Unit	Unit Thickness	Depth to Top
Subs. SWL	Date	Analysis	Aquifer Test
Driller's Remarks			

DESCRIPTION OF FORMATIONS ENCOUNTERED	FROM	TO	FORMATIONS (Continued)
<u>Mud</u>	<u>0</u>	<u>10</u>	<div align="center" style="border: 2px solid black; padding: 10px; font-size: 2em; font-weight: bold; transform: rotate(-5deg);"> RECEIVED NOV 3 1986 </div> <p align="right">Department of Natural Resources Bureau of Land & Water Resources</p>
<u>Mud</u>	<u>10</u>	<u>60</u>	
<u>Mud</u>	<u>60</u>	<u>100</u>	
<u>Sand</u>	<u>100</u>	<u>130</u>	
<u>Mud</u>	<u>130</u>	<u>160</u>	
<u>Sand</u>	<u>160</u>	<u>220</u>	
<u>Mud</u>	<u>220</u>	<u>250</u>	
<u>Sand</u>	<u>250</u>	<u>...</u>	

IF MORE SPACE IS NEEDED, USE BACK

If well telescopes please
sketch and show depths.

GROUND LEVEL

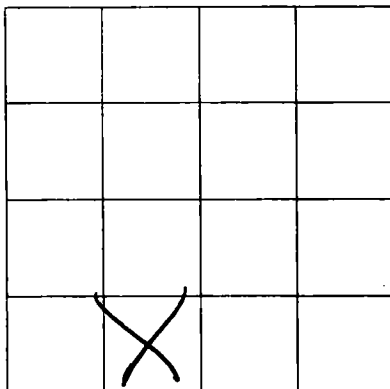

SECTION _____

Please indicate well location X.

ADDITIONAL INFORMATION

If more than one screen,
show location of each on sketch.