

MISSISSIPPI DEPARTMENT OF NATURAL RESOURCES
Bureau of Land and Water Resources

P.O. Box 10631
Jackson, Mississippi 39209
WATER WELL DRILLERS LOG

COUNTY WELL LOCATED HANCOCK	
WELL NUMBER K 2677	CODED
DATE WELL COMPLETED OCT. 7 - 1986	

PERMIT NUMBER
NAME OF DRILLING FIRM WARD WELL DLG.
BAY ST. LOUIS

NAME & MAILING ADDRESS OF LANDOWNER CHARLES DUFFY		
WEST FORREST ST.		
BAY ST. LOUIS MS.		
WELL LOCATION:	SEC	TOWNSHIP
	6	9 N 14 E
DISTANCE	DIRECTION	NEAREST TOWN
6 Miles	W	of WAVELAND
OTHER LANDMARK BAY SIDE PARK SUDU.		
WELL PURPOSE: Home, Irrigation, Municipal, Industrial, Fish Pond, etc. HOME		

PUMP DATA		
PUMP TYPE (Circle One): Submersible, Turbine, Jet, Flowing Well, Other (Describe) _____		
POWER TYPE (Circle One): Electric, Tractor, Diesel, Gasoline, Butane, Other (Describe) _____		
Pump Capacity (GPM)	No. of Stages	Setting Depth FT.
PUMP TEST		
Well yielded _____ GPM with a drawdown of _____ ft. after _____ hours of pumping		

WELL DATA		
Well Depth 160	Casing Diameter (In.) 2	Casing Length (Ft.) 150
Type of Casing PVC	Hole Depth 160	Depth to Static Water Level - 17 FT.
TYPE OF COMPLETION: (Circle One or More): Gravel Packed, Underreamed, Telescoped, <u>Natural Development</u> , Open Hole, Other (Describe) BACK FILLED		
Top of Lap Pipe or Reduction in Casing FEET IF TELESCOPED OR MORE THAN ONE SCREEN: USE BACK PAGE		

LOG DATA	
TYPE OF LOG RUN (Circle One): Electric, Gamma Ray, Density, Sonic, Neutron, Other (Describe) _____ No Log Run	
Name of Organization Running Log	

SCREEN DATA		
Diameter - Inches 2	Length - Feet 10	Slot Size - Inches 10
Screen Type SCH. 80 - PVC	Depth to Bottom - Feet 160	


GEOLOGIC DATA (Office Use Only)			
Surface Elev.	Geologic Unit	Unit Thickness	Depth to Top
Subs. SWL	Date	Analysis	Aquifer Test
Driller's Remarks N/A			

DESCRIPTION OF FORMATIONS ENCOUNTERED	FROM	TO
FILL - CLAY	0	18
SD	18	48
CLAY	48	96
SD	96	128
CLAY - SILT	128	145
PEA GRAVEL - SD	145	160

RECEIVED	
DEC 09 1986	
Department of Natural Resources Bureau of Land & Water Resources	
IF MORE SPACE IS NEEDED, USE BACK	

If well telescopes please sketch and show depths.

GROUND LEVEL

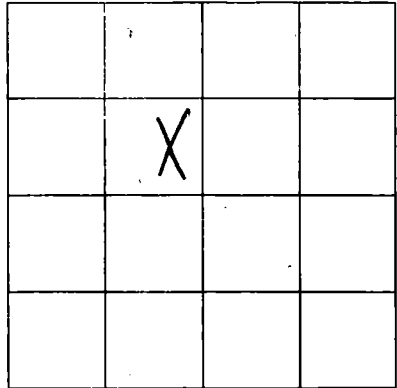

SECTION 6

Please indicate well location X.

ADDITIONAL INFORMATION

A series of horizontal lines for writing additional information.

If more than one screen, show location of each on sketch.