

MISSISSIPPI DEPARTMENT OF NATURAL RESOURCES

Bureau of Land and Water Resources

P.O. Box 10631

Jackson, Mississippi 39209

WATER WELL DRILLERS LOG

COUNTY WELL LOCATED HANCOCK	
WELL NUMBER R 2678	CODED
DATE WELL COMPLETED OCT. 10 - 1986	

PERMIT NUMBER
NAME OF DRILLING FIRM WARD WELL DRG.
BAY ST. LOUIS

NAME & MAILING ADDRESS OF LANDOWNER HATTIE CHAMPINE			
LAKESHORE SD.			
LAKESHORE, MS.			
WELL LOCATION:	SEC	TOWNSHIP	RANGE
	18	9	14
		S	W
DISTANCE	DIRECTION	NEAREST TOWN	
4 Miles	S/W	CLEARMONT HARBOR	
OTHER LANDMARK			
WELL PURPOSE: Home, Irrigation, Municipal, Industrial, Fish Pond, etc. HOME			

PUMP DATA		
PUMP TYPE (Circle One): Submersible, Turbine, Jet, Flowing Well, Other (Describe) SHALLOW WELL JET		
POWER TYPE (Circle One): <input checked="" type="radio"/> Electric, Tractor, Diesel, Gasoline, Butane, Other (Describe)		
Pump Capacity (GPM)	No. of Stages	Setting Depth
10	1	20 FT.
PUMP TEST		
Well yielded 10 GPM with a drawdown of 3 ft. after 2 hours of pumping		

WELL DATA		
Well Depth 315	Casing Diameter (In.) 2	Casing Length (Ft.) 305
Type of Casing PVC	Hole Depth 315	Depth to Static Water Level -14 FT.
TYPE OF COMPLETION: (Circle One or More): Gravel Packed, Underreamed, Telescoped, <input checked="" type="checkbox"/> Natural Development, Open Hole, Other (Describe) BACK FILLED		
Top of Lap Pipe or Reduction in Casing FEET <input type="checkbox"/> IF TELESCOPED OR MORE THAN ONE SCREEN: USE BACK PAGE		

LOG DATA	
TYPE OF LOG RUN (Circle One): Electric, Gamma Ray, Density, Sonic, Neutron, Other (Describe) No Log Run	
Name of Organization Running Log	

SCREEN DATA		
Diameter - Inches 2	Length - Feet 10	Slot Size - Inches 10
Screen Type SCH. 80 - PVC	Depth to Bottom - Feet 315	

GEOLOGIC DATA (Office Use Only)			
Surface Elev.	Geologic Unit	Unit Thickness	Depth to Top
Subs. SWL	Date	Analysis	Aquifer Test


Driller's Remarks N/A

DESCRIPTION OF FORMATIONS ENCOUNTERED	FROM	TO
CLAY SD	0	10
CLAY SD	10	48
CLAY-SHELL	48	56
CLAY-SILT	56	95
PEA GRAVEL - SD	95	116
CLAY-SILT	116	210
FINE SD	210	225
CLAY-SILT	225	278
CORSE SD	278	315

<div style="font-size: 2em; font-weight: bold; opacity: 0.5;">RECEIVED</div> <p style="font-size: 1.5em; font-weight: bold;">DEC 09 1986</p> <p style="font-weight: bold;">Department of Natural Resources Bureau of Land & Water Resources</p>	FORM NO. 1 (Continued)	FROM	TO
IF MORE SPACE IS NEEDED, USE BACK			

If well telescopes please sketch and show depths.

GROUND LEVEL

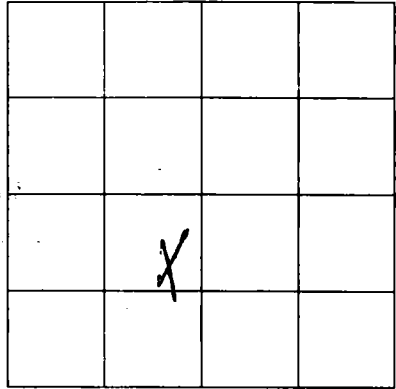

SECTION 18

Please indicate well location X.

ADDITIONAL INFORMATION

If more than one screen,
show location of each on sketch.