

MISSISSIPPI DEPARTMENT OF NATURAL RESOURCES

Bureau of Land and Water Resources

P.O. Box 10631

Jackson, Mississippi 39209

WATER WELL DRILLERS LOG

COUNTY WELL LOCATED <i>Hancock</i>	
WELL NUMBER <i>R 2681</i>	CODED
DATE WELL COMPLETED <i>10-31-86</i>	

PERMIT NUMBER
NAME OF DRILLING FIRM <i>WARD WELL DRG.</i>
<i>Rt. 2, Box 350C, B.S.L.</i>

NAME & MAILING ADDRESS OF LANDOWNER <i>Herman Johnson</i>			
<i>Klein Subv.</i>			
<i>Bay St. Louis ms.</i>			
WELL LOCATION: SEC	TOWNSHIP	RANGE	
<i>8</i>	<i>9</i>	<i>14</i>	<i>W</i>
DISTANCE	DIRECTION	NEAREST TOWN	
<i>11</i> Miles	<i>W</i>	of <i>B.S.L.</i>	
OTHER LANDMARK <i>Klein Subv.</i>			
WELL PURPOSE: Home, Irrigation, Municipal, Industrial, Fish Pond, etc. <i>Home</i>			

PUMP DATA		
PUMP TYPE (Circle One): Submersible, Turbine, <u>Jet</u> Flowing Well, Other (Describe) _____		
POWER TYPE (Circle One): <u>Electric</u> , Tractor, Diesel, Gasoline, Butane, Other (Describe) _____		
Pump Capacity (GPM) <i>10</i>	No. of Stages <i>1</i>	Setting Depth <i>-</i> FT.
PUMP TEST		
Well yielded _____ GPM with a drawdown of _____ ft. after _____ hours of pumping		

WELL DATA		
Well Depth <i>295</i>	Casing Diameter (In.) <i>2"</i>	Casing Length (Ft.) <i>285</i>
Type of Casing <i>SCH. 40 PVC</i>	Hole Depth <i>295</i>	Depth to Static Water Level <i>- 15 ft.</i>
TYPE OF COMPLETION: (Circle One or More): Gravel Packed, Underreamed, Telescoped, <u>Natural Development</u> , <u>Backfilled</u> , Open Hole, Other		
Top of Lap Pipe or Reduction in Casing FEET		
IF TELESCOPED OR MORE THAN ONE SCREEN: USE BACK PAGE		

LOG DATA	
TYPE OF LOG RUN (Circle One): Electric, Gamma Ray, Density, Sonic, Neutron, Other (Describe) _____	
<u>No Log Run</u>	
Name of Organization Running Log	

SCREEN DATA		
Diameter - Inches <i>2</i>	Length - Feet <i>10</i>	Slot Size - Inches <i>8</i>
Screen Type <i>SCH. 80 PVC</i>	Depth to Bottom - Feet <i>295</i>	

GEOLOGIC DATA (Office Use Only)			
Surface Elev.	Geologic Unit	Unit Thickness	Depth to Top
Subs. SWL	Date	Analysis	Aquifer Test
<div style="font-size: 2em; font-weight: bold; opacity: 0.5; transform: rotate(-15deg); display: inline-block;">RECEIVED</div> DEC 22 1986			


DESCRIPTION OF FORMATIONS ENCOUNTERED	FROM	TO
<i>fill - clay</i>	<i>0</i>	<i>12</i>
<i>sd</i>	<i>12</i>	<i>52</i>
<i>clay</i>	<i>52</i>	<i>65</i>
<i>clay w/ shell</i>	<i>65</i>	<i>76</i>
<i>clay</i>	<i>76</i>	<i>95</i>
<i>Reddish-brown - sd</i>	<i>95</i>	<i>126</i>
<i>clay - silt</i>	<i>126</i>	<i>210</i>
<i>fine sd</i>	<i>210</i>	<i>222</i>
<i>clay - silt</i>	<i>222</i>	<i>270</i>
<i>coarse sd</i>	<i>270</i>	<i>295</i>

DEPARTMENT OF Natural Resources Bureau of Land & Water Resources		
(Continued)	FROM	TO

IF MORE SPACE IS NEEDED, USE BACK

If well telescopes please
sketch and show depths.

GROUND LEVEL

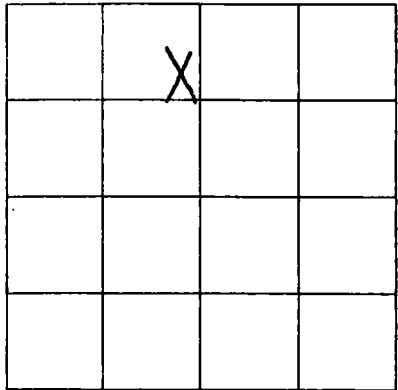

SECTION 8

Please indicate well location X.

ADDITIONAL INFORMATION

If more than one screen,
show location of each on sketch.