

**MISSISSIPPI DEPARTMENT OF NATURAL RESOURCES**  
Bureau of Land and Water Resources

P.O. Box 10631  
Jackson, Mississippi 39209  
**WATER WELL DRILLERS LOG**

COUNTY WELL LOCATED <i>Hancock</i>	
WELL NUMBER <i>R 2683</i>	CODED
DATE WELL COMPLETED <i>Nov. 3, 1986</i>	

PERMIT NUMBER
NAME OF DRILLING FIRM <i>Ward Well Dr.</i>
<i>Rt. 2, Box 350 C. B.S.L.</i>

NAME & MAILING ADDRESS OF LANDOWNER <i>Joe Calamini</i>			
<i>Lower Bay Rd.</i>			
<i>Bay St. Louis, ms.</i>			
WELL LOCATION:	SEC	TOWNSHIP	RANGE
	<i>8</i>	<i>9</i>	<i>14</i> <sup>N</sup> <sub>S</sub> <sup>E</sup> <sub>W</sub>
DISTANCE	DIRECTION	NEAREST TOWN	
<i>6</i>	<i>S/W</i>	<i>Warland</i>	
OTHER LANDMARK			
WELL PURPOSE: Home, Irrigation, Municipal, Industrial, Fish Pond, etc. <i>Home</i>			

<b>PUMP DATA</b>		
PUMP TYPE (Circle One): Submersible, Turbine, Jet, Flowing Well, Other (Describe) <u><i>owner</i></u>		
POWER TYPE (Circle One): Electric, Tractor, Diesel, Gasoline, Butane, Other (Describe)		
Pump Capacity (GPM)	No. of Stages	Setting Depth  <b>FT.</b>
PUMP TEST		
Well yielded _____ GPM with a drawdown of _____ ft. after _____ hours of pumping		

<b>WELL DATA</b>		
Well Depth <i>320 ft.</i>	Casing Diameter (In.) <i>2"</i>	Casing Length (Ft.) <i>310 ft.</i>
Type of Casing <i>Sh. 40 PVC</i>	Hole Depth <i>320</i>	Depth to Static Water Level <i>- 10 ft.</i>
TYPE OF COMPLETION: (Circle One or More): Gravel Packed, Underreamed, Telescoped, <u>Natural Development</u> , Open Hole, Other (Describe) <u><i>Backfilled</i></u>		
Top of Lap Pipe or Reduction in Casing  <b>FEET</b> IF TELESCOPED OR MORE THAN ONE SCREEN: USE BACK PAGE		

<b>LOG DATA</b>	
TYPE OF LOG RUN (Circle One): Electric, Gamma Ray, Density, Sonic, Neutron, Other (Describe) <u><i>No Log Run</i></u>	
Name of Organization Running Log <i>N/A</i>	

<b>SCREEN DATA</b>		
Diameter - Inches <i>2"</i>	Length - Feet <i>10 ft.</i>	Slot Size - Inches <i>10 Slot</i>
Screen type <i>Sh. 80 PVC</i>	Depth to Bottom - Feet <i>370</i>	


<b>GEOLOGIC DATA (Office Use Only)</b>			
Surface Elev.	Geologic Unit	Unit Thickness	Depth to Top
Subs. SWL	Date	Analysis	Aquifer Test
Driller's Remarks <i>N/A</i>			

DESCRIPTION OF FORMATIONS ENCOUNTERED	FROM	TO	FORMATIONS (Continued)	FROM	TO
<i>Fill - Clay</i>	<i>0</i>	<i>10</i>	<b>RECEIVED</b> <i>DEC 22 1986</i> Department of Natural Resources Bureau of Land & Water Resources		
<i>Sd</i>	<i>10</i>	<i>42</i>			
<i>Clay</i>	<i>42</i>	<i>94</i>			
<i>Sd - The Mound</i>	<i>94</i>	<i>115</i>			
<i>Clay - Silt</i>	<i>115</i>	<i>190</i>			
<i>Fine Sd</i>	<i>190</i>	<i>230</i>			
<i>Clay</i>	<i>230</i>	<i>276</i>			
<i>Coarse Sd</i>	<i>276</i>	<i>320</i>			

IF MORE SPACE IS NEEDED, USE BACK

If well telescopes please sketch and show depths.

GROUND LEVEL

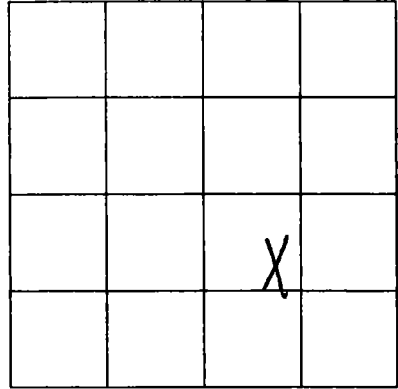

SECTION 8

Please indicate well location X.

ADDITIONAL INFORMATION

If more than one screen,  
show location of each on sketch.