

MISSISSIPPI DEPARTMENT OF NATURAL RESOURCES
Bureau of Land and Water Resources

P.O. Box 10631
Jackson, Mississippi 39209
WATER WELL DRILLERS LOG

COUNTY WELL LOCATED <i>Hancock</i>	
WELL NUMBER <i>K 2684</i>	CODED
DATE WELL COMPLETED <i>11-5-86</i>	

PERMIT NUMBER
NAME OF DRILLING FIRM <i>Wood Well Drg</i>
<i>Rt. 2, Box 350C, B.S.L.</i>

NAME & MAILING ADDRESS OF LANDOWNER <i>R. Glotie</i>		
<i>2nd St. & Sagan</i>		
<i>Bay St. Louis, ms.</i>		
WELL LOCATION: SEC	TOWNSHIP	RANGE
<i>28</i>	<i>8 N</i>	<i>14 E</i>
DISTANCE	DIRECTION	NEAREST TOWN
<i>5</i> Miles	<i>N/W</i>	<i>of Woodland</i>
OTHER LAND MARK <i>Shoreline Park</i>		
WELL PURPOSE: Home, Irrigation, Municipal, Industrial, Fish Pond, etc. <i>Camp</i>		

PUMP DATA		
PUMP TYPE (Circle One): Submersible, Turbine, Jet, Flowing Well, Other (Describe) <i>runner</i>		
POWER TYPE (Circle One): Electric, Tractor, Diesel, Gasoline, Butane, Other (Describe)		
Pump Capacity (GPM)	No. of Stages	Setting Depth FT.
PUMP TEST		
Well yielded _____ GPM with a drawdown of _____ ft. after _____ hours of pumping		

WELL DATA		
Well Depth <i>170 ft.</i>	Casing Diameter (In.) <i>2"</i>	Casing Length (Ft.) <i>160 ft.</i>
Type of Casing <i>Sch. 40 PVC</i>	Hole Depth <i>170</i>	Depth to Static Water Level <i>- 7 ft.</i>
TYPE OF COMPLETION: (Circle One or More): Gravel Packed, Underreamed, Telescoped, <input checked="" type="checkbox"/> Natural Development, <input type="checkbox"/> Open Hole, <input type="checkbox"/> Other (Describe) <i>back filled</i>		
Top of Lap Pipe or Reduction in Casing FEET IF TELESCOPED OR MORE THAN ONE SCREEN: USE BACK PAGE		

LOG DATA	
TYPE OF LOG RUN (Circle One): Electric, Gamma Ray, Density, Sonic, Neutron, Other (Describe) <input checked="" type="checkbox"/> No Log Run	
Name of Organization Running Log <i>N/A</i>	

SCREEN DATA		
Diameter - Inches <i>2"</i>	Length - Feet <i>10 ft.</i>	Slot Size - Inches <i>8 Slot</i>
Screen Type <i>Sch. 80 PVC</i>	Depth to Bottom - Feet <i>- 170</i>	

GEOLOGIC DATA (Office Use Only)			
Surface Elev.	Geologic Unit	Unit Thickness	Depth to Top
Subs. SWL	Date	Analysis	Aquifer Test

Driller's Remarks <i>N/A</i>

DESCRIPTION OF FORMATIONS ENCOUNTERED	FROM	TO	FORMATIONS (Continued)	FROM	TO
<i>Clay</i>	<i>10</i>	<i>14</i>			
<i>sd</i>	<i>14</i>	<i>54</i>			
<i>clay-silt</i>	<i>54</i>	<i>105</i>			
<i>fine sd</i>	<i>105</i>	<i>120</i>			
<i>clay-silt</i>	<i>120</i>	<i>152</i>			
<i>coar sd</i>	<i>152</i>	<i>170</i>			


RECEIVED

DEC 22 1986

Department of Natural Resources
Bureau of Land & Water Resources

If well telescopes please sketch and show depths.

GROUND LEVEL

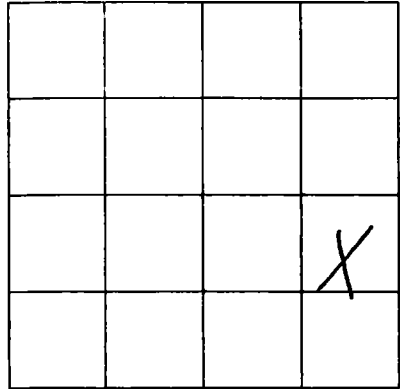

SECTION 28

Please indicate well location X.

ADDITIONAL INFORMATION

If more than one screen,
show location of each on sketch.