

MISSISSIPPI DEPARTMENT OF NATURAL RESOURCES
Bureau of Land and Water Resources

P.O. Box 10631

Jackson, Mississippi 39209

WATER WELL DRILLERS LOG

COUNTY WELL LOCATED <u>Hancock</u>	
WELL NUMBER <u>K2697</u>	CODED
DATE WELL COMPLETED <u>Mar. 3 1987</u>	

PERMIT NUMBER
NAME OF DRILLING FIRM <u>WARD WELL DRG.</u>

NAME & MAILING ADDRESS OF LANDOWNER <u>AL BERNARD</u> <u>Lakeshore Rd.</u> <u>Lakeshore, ms.</u>			
WELL LOCATION:	SEC	TOWNSHIP	RANGE
	<u>24</u>	<u>9</u>	<u>N 14</u> <u>(W)</u>
DISTANCE	DIRECTION	NEAREST TOWN	
<u>12</u>	Miles <u>S/W</u>	of <u>Woodland</u>	
OTHER LANDMARK <u>Bayou Caddy</u>			
WELL PURPOSE: Home, Irrigation, Municipal, Industrial, Fish Pond, etc.			

PUMP DATA		
PUMP TYPE (Circle One): Submersible, Turbine, Jet, Flowing Well, Other (Describe) <u>runner</u>		
POWER TYPE (Circle One): Electric, Tractor, Diesel, Gasoline, Butane, Other (Describe)		
Pump Capacity (GPM)	No. of Stages	Setting Depth
		FT.
PUMP TEST		
Well yielded _____ GPM with a drawdown of _____ ft. after _____ hours of pumping		

WELL DATA		
Well Depth <u>398</u>	Casing Diameter (In.) <u>2"</u>	Casing Length (Ft.) <u>388</u>
Type of Casing <u>Sch. 40 PVC</u>	Hole Depth <u>398</u>	Depth to Static Water Level <u>- 5 ft.</u>
TYPE OF COMPLETION: (Circle One or More): Gravel Packed, Underreamed, Telescoped, <u>Natural Development</u> , Open Hole, Other		
Top of Lap Pipe or Reduction in Casing FEET <input type="checkbox"/> IF TELESCOPED OR MORE THAN ONE SCREEN: USE BACK PAGE		

LOG DATA	
TYPE OF LOG RUN (Circle One): Electric, Gamma Ray, Density, Sonic, Neutron, Other (Describe) <u>No Log Run</u>	
Name of Organization Running Log	

SCREEN DATA		
Diameter - Inches <u>2"</u>	Length - Feet <u>10 ft.</u>	Slot Size - inches <u>8 Slot</u>
Screen Type <u>Sch. 80 PVC</u>	Depth to Bottom - Feet <u>398</u>	

GEOLOGIC DATA (Office Use Only)			
Surface Elev.	Geologic Unit	Unit Thickness	Depth to Top
Subs. SWL	Date	Analysis	Aquifer Test

Driller's Remarks

RECEIVED



DESCRIPTION OF FORMATIONS ENCOUNTERED	FROM	TO	FORMATIONS (Continued)	FROM	TO
<u>Fill</u>	<u>0</u>	<u>2</u>	<u>MAY 11 1987</u>		
<u>Clay</u>	<u>2</u>	<u>16</u>			
<u>Sd</u>	<u>16</u>	<u>46</u>			
<u>Clay w/ shell</u>	<u>46</u>	<u>105</u>			
<u>Red Marl - Sd</u>	<u>105</u>	<u>130</u>			
<u>Clay - Silt</u>	<u>130</u>	<u>240</u>			
<u>Fine Sd</u>	<u>240</u>	<u>284</u>			
<u>Clay - Silt</u>	<u>284</u>	<u>365</u>			
<u>Red Marl - Sd</u>	<u>365</u>	<u>398</u>			

IF MORE SPACE IS NEEDED, USE BACK

If well telescopes please sketch and show depths.

GROUND LEVEL

assume Sec. 24, well
not find Sec. number.

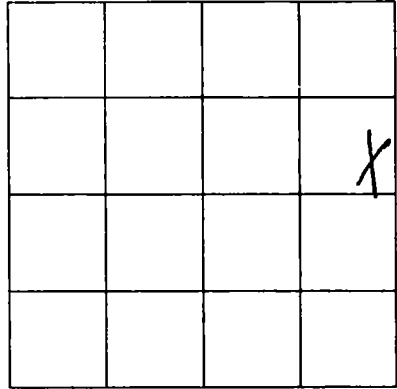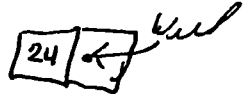

SECTION 24

Please indicate well location X.

ADDITIONAL INFORMATION

If more than one screen,
show location of each on sketch.