

MISSISSIPPI DEPARTMENT OF NATURAL RESOURCES
Bureau of Land and Water Resources

P.O. Box 10631
Jackson, Mississippi 39209
WATER WELL DRILLERS LOG

COUNTY WELL LOCATED <i>Marion</i>	
WELL NUMBER <i>R 2707</i>	CODED
DATE WELL COMPLETED <i>May 12 1987</i>	

PERMIT NUMBER
NAME OF DRILLING FIRM <i>Ward Well Dlg.</i>

NAME & MAILING ADDRESS OF LANDOWNER <i>Col. Earnest Brady</i> <i>Union St.</i> <i>Bay St. Louis ms.</i>		
WELL LOCATION: SEC	TOWNSHIP	RANGE
<i>29</i>	<i>8</i>	<i>N 14 E</i>
DISTANCE	DIRECTION	NEAREST TOWN
<i>5</i> Miles	<i>N/W</i>	<i>Waveland</i>
OTHER LANDMARK <i>Shoreline Park Sidel.</i>		
WELL PURPOSE: Home, Irrigation, Municipal, Industrial, Fish Pond, etc. <i>Home</i>		

PUMP DATA		
PUMP TYPE (Circle One): Submersible, Turbine, Jet, Flowing Well, Other (Describe) <u><i>Owner</i></u>		
POWER TYPE (Circle One): Electric, Tractor, Diesel, Gasoline, Butane, Other (Describe) _____		
Pump Capacity (GPM)	No. of Stages	Setting Depth
		FT.
PUMP TEST		
Well yielded _____ GPM with a drawdown of _____ ft. after _____ hours of pumping		

WELL DATA		
Well Depth <i>188</i>	Casing Diameter (In.) <i>2"</i>	Casing Length (Ft.) <i>178 ft.</i>
Type of Casing <i>Sh. 40 PVC</i>	Hole Depth <i>188</i>	Depth to Static Water Level <i>- 8 ft.</i>
TYPE OF COMPLETION: (Circle One or More): Gravel Packed, Underreamed, Telescoped, <u>Natural Development</u> , Open Hole, Other (Describe) <u><i>Bar-filled</i></u>		
Top of Lap Pipe or Reduction in Casing		
FEET	IF TELESCOPED OR MORE THAN ONE SCREEN: USE BACK PAGE	

LOG DATA	
TYPE OF LOG RUN (Circle One): Electric, Gamma Ray, Density, Sonic, Neutron, Other (Describe) <u><i>No Log Run</i></u>	
Name of Organization Running Log	

SCREEN DATA		
Diameter - Inches <i>2"</i>	Length - Feet <i>10 ft.</i>	Slot Size - Inches <i>8</i>
Screen Type <i>Sh. 80 PVC</i>	Depth to Bottom - Feet <i>-188</i>	


GEOLOGIC DATA (Office Use Only)			
Surface Elev.	Geologic Unit	Unit Thickness	Depth to Top
Subs. SWL	Date	Analysis	Aquifer Test
Driller's Remarks			

DESCRIPTION OF FORMATIONS ENCOUNTERED	FROM	TO
<i>Clay</i>	<i>0</i>	<i>18</i>
<i>sd</i>	<i>18</i>	<i>52</i>
<i>Clay</i>	<i>52</i>	<i>98</i>
<i>Hard sd</i>	<i>98</i>	<i>116</i>
<i>Clay - silt</i>	<i>116</i>	<i>155</i>
<i>Coar sd</i>	<i>155</i>	<i>188</i>

RECEIVED	
<i>JUL 10 1987</i>	
Department of Natural Resources Bureau of Land & Water Resources	
IF MORE SPACE IS NEEDED, USE BACK	

If well telescopes please sketch and show depths.

GROUND LEVEL

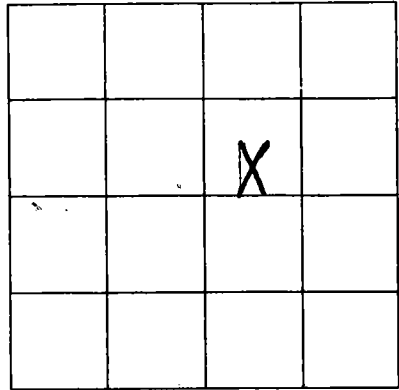

SECTION 29

Please indicate well location X.

ADDITIONAL INFORMATION

If more than one screen,
show location of each on sketch.