

MISSISSIPPI DEPARTMENT OF NATURAL RESOURCES
Bureau of Land and Water Resources

P.O. Box 10631

Jackson, Mississippi 39209

WATER WELL DRILLERS LOG

COUNTY WELL LOCATED HANCOCK	
WELL NUMBER K 2716	CODED
DATE WELL COMPLETED JULY 17, 1987	

PERMIT NUMBER
NAME OF DRILLING FIRM WARD WELL DLG.
D.T. 2, BOX 350C, A.S.L, MS

NAME & MAILING ADDRESS OF LANDOWNER STEPHEN Lombardo		
FIG ST.		
BAY ST. LOUIS, MS.		
WELL LOCATION: SEC	TOWNSHIP	RANGE
30	8	N 14 W
DISTANCE	DIRECTION	NEAREST TOWN
7 Miles	N/W of	WALDRON
OTHER LANDMARK BAY P. LILLI'S SUBD.		
WELL PURPOSE: Home, Irrigation, Municipal, Industrial, Fish Pond, etc. HOME		

PUMP DATA		
PUMP TYPE (Circle One): Submersible, Turbine, Jet, Flowing Well, Other (Describe) OWNERS		
POWER TYPE (Circle One): Electric, Tractor, Diesel, Gasoline, Butane, Other (Describe)		
Pump Capacity (GPM)	No. of Stages	Setting Depth FT.
PUMP TEST		
Well yielded _____ GPM with a drawdown of _____ ft. after _____ hours of pumping		

WELL DATA		
Well Depth 118 FT.	Casing Diameter (In.) 2"	Casing Length (Ft.) 108 FT.
Type of Casing SCH. 40 PVC	Hole Depth 118 FT.	Depth to Static Water Level - 6 FT.
TYPE OF COMPLETION: (Circle One or More): Gravel Packed, Underreamed, Telescoped, Natural Development, Open Hole, Other (Describe) BWU & AIR		
Top of Lap Pipe or Reduction in Casing FEET IF TELESCOPED OR MORE THAN ONE SCREEN: USE BACK PAGE		

LOG DATA	
TYPE OF LOG RUN (Circle One): Electric, Gamma Ray, Density, Sonic, No Log Run , Neutron, Other (Describe)	
Name of Organization Running Log	

SCREEN DATA		
Diameter - Inches 2"	Length - Feet 10 FT.	Slot Size - Inches .008 SLOT
Screen Type SCH. 80 PVC	Depth to Bottom - Feet 118	

GEOLOGIC DATA (Office Use Only)			
Surface Elev.	Geologic Unit	Unit Thickness	Depth to Top
Subs. SWL	Date	Analysis	Aquifer Test
Driller's Remarks N/A			

DESCRIPTION OF FORMATIONS ENCOUNTERED	FROM	TO
CLAY	0	12
sd	12	48
CLAY	48	96
sd - PEA GRAUGL	96	118

FORMATION	DEPTH	DATE

RECEIVED


OCT 09 1987

Department of Natural Resources
Bureau of Land & Water Resources

IF MORE SPACE IS NEEDED, USE BACK

If well telescopes please sketch and show depths.

GROUND LEVEL

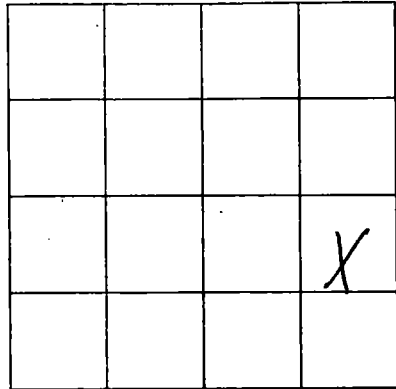

SECTION 30

Please indicate well location X.

ADDITIONAL INFORMATION

If more than one screen,
show location of each on sketch.