

MISSISSIPPI DEPARTMENT OF NATURAL RESOURCES
Bureau of Land and Water Resources

P.O. Box 10631

Jackson, Mississippi 39209

WATER WELL DRILLERS LOG

COUNTY WELL LOCATED <i>Hancock</i>		
WELL NUMBER <i>R2718</i>	CODED	PERMIT NUMBER
NAME OF DRILLING FIRM <i>Wood Well Dr.</i>		
DATE WELL COMPLETED <i>July 29 1987</i>		
NAME & MAILING ADDRESS OF LANDOWNER <i>High Sully Georgia St. Bay St. Louis, Mo.</i>		
WELL LOCATION:	SEC	TOWNSHIP
	<i>29</i>	<i>8</i>
		RANGE
		<i>N 14 1/2 E</i>
DISTANCE	DIRECTION	NEAREST TOWN
<i>5</i> Miles	<i>NW</i>	<i>Clarendon</i>
OTHER LANDMARK <i>Shoreline Park Sully</i>		
WELL PURPOSE: Home, Irrigation, Municipal, Industrial, Fish Pond, etc. <i>Home</i>		

PUMP DATA		
PUMP TYPE (Circle One): Submersible, Turbine, <u>Jet</u> , Flowing Well, Other (Describe) <i>Shallow well</i>		
POWER TYPE (Circle One): <u>Electric</u> , Tractor, Diesel, Gasoline, Butane, Other (Describe)		
Pump Capacity (GPM) <i>10</i>	No. of Stages <i>1</i>	Setting Depth <i>20</i> FT.
PUMP TEST		
Well yielded _____ GPM with a drawdown of _____ ft. after _____ hours of pumping		

WELL DATA		
Well Depth <i>157 ft.</i>	Casing Diameter (In.) <i>2"</i>	Casing Length (Ft.) <i>147 ft.</i>
Type of Casing <i>Sh. PVC</i>	Hole Depth <i>157 ft.</i>	Depth to Static Water Level <i>-7 ft.</i>
TYPE OF COMPLETION (Circle One or More): Gravel Packed, Underreamed, Telescoped, Natural Development, Open Hole, Other (Describe) <i>Backpack & air</i>		
Top of Lap Pipe or Reduction in Casing		
FEET	IF TELESCOPED OR MORE THAN ONE SCREEN: USE BACK PAGE	

LOG DATA	
TYPE OF LOG RUN (Circle One): Electric, Gamma Ray, Density, Sonic, <u>No Log Run</u> , Neutron, Other (Describe)	
Name of Organization Running Log <i>N/A</i>	

SCREEN DATA		
Diameter - Inches <i>2"</i>	Length - Feet <i>10 ft.</i>	Slot Size - Inches <i>.008 Slot</i>
Screen Type <i>Sch. 80 PVC</i>	Depth to Bottom - Feet <i>157</i>	

GEOLOGIC DATA (Office Use Only)			
Surface Elev.	Geologic Unit	Unit Thickness	Depth to Top
Subs. SWL	Date	Analysis	Aquifer Test


Driller's Remarks <i>N/A</i>

DESCRIPTION OF FORMATIONS ENCOUNTERED	FROM	TO
<i>Fill - clay</i>	<i>0</i>	<i>15</i>
<i>sd</i>	<i>15</i>	<i>45</i>
<i>clay</i>	<i>45</i>	<i>99</i>
<i>clay & fine sd</i>	<i>99</i>	<i>118</i>
<i>clay - fill</i>	<i>118</i>	<i>140</i>
<i>med. coarse sd</i>	<i>140</i>	<i>157</i>

FORMATIONS (Continued)	FROM	TO
RECEIVED		
<i>OCT 09 1987</i>		
Department of Natural Resources Bureau of Land & Water Resources		
IF MORE SPACE IS NEEDED, USE BACK		

If well telescopes please sketch and show depths.

GROUND LEVEL

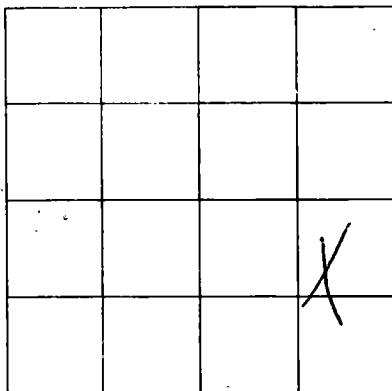

SECTION 40

Please indicate well location X.

ADDITIONAL INFORMATION

If more than one screen,
show location of each on sketch.