

**MISSISSIPPI DEPARTMENT OF NATURAL RESOURCES**  
Bureau of Land and Water Resources

P.O. Box 10631  
Jackson, Mississippi 39209  
**WATER WELL DRILLERS LOG**

COUNTY WELL LOCATED <i>Hancock</i>	
WELL NUMBER <i>R 2719</i>	CODED
DATE WELL COMPLETED <i>Aug. 18, 1987</i>	

PERMIT NUMBER
NAME OF DRILLING FIRM <i>Ward Well Dg.</i>
<i>Pt. 2 BY 350 C, B.S.L.</i>

NAME & MAILING ADDRESS OF LANDOWNER <i>Carl Hutzman Constant</i>		
<i> Hwy 90</i>		
<i> Waveland ms.</i>		
WELL LOCATION:	SEC	TOWNSHIP
	<i>30</i>	<i>8</i>
		RANGE <i>14</i> <i>30</i> <i>E</i>
DISTANCE	DIRECTION	NEAREST TOWN
<i>7</i>	<i>N/W</i>	<i>Waveland</i>
OTHER LANDMARK <i>Bayou Phillip's Sudd.</i>		
WELL PURPOSE: Home, Irrigation, Municipal, Industrial, Fish Pond, etc. <i>Home &amp; Heat Pump</i>		

<b>PUMP DATA</b>		
PUMP TYPE (Circle One): <input checked="" type="radio"/> <u>Submersible</u> Turbine,    Jet    Flowing Well, Other (Describe) _____		
POWER TYPE (Circle One): <input checked="" type="radio"/> <u>Electric</u> Tractor,    Diesel,    Gasoline,    Butane, Other (Describe) _____		
Pump Capacity (GPM)	No. of Stages	Setting Depth
<i>30</i>	<i>8</i>	<i>40</i> FT.
PUMP TEST		
Well yielded _____ GPM with a drawdown of _____ ft. after _____ hours of pumping		

<b>WELL DATA</b>		
Well Depth	Casing Diameter (In.)	Casing Length (Ft.)
<i>399</i>	<i>4" X 2"</i>	<i>379</i>
Type of Casing	Hole Depth	Depth to Static Water Level
<i>Sh. 40 PVC</i>	<i>399'</i>	<i>+ 3 ft.</i>
TYPE OF COMPLETION: (Circle One or More): Gravel Packed,    Underreamed,    Telescoped, Natural Development,    Open Hole, <input checked="" type="radio"/> <u>Other</u> (Describe) <i>Backward - an</i>		
Top of Lap Pipe or Reduction in Casing		
FEET	IF TELESCOPED OR MORE THAN ONE SCREEN: USE BACK PAGE	

<b>LOG DATA</b>	
TYPE OF LOG RUN (Circle One): Electric,    Gamma Ray,    Density,    Sonic, <input checked="" type="radio"/> <u>No Log Run</u> , Other (Describe) _____	
Name of Organization Running Log	


<b>SCREEN DATA</b>		
Diameter - Inches	Length - Feet	Slot Size - Inches
<i>2"</i>	<i>20</i>	<i>1008</i>
Screen Type	Depth to Bottom - Feet	
<i>Sh. 80 PVC</i>	<i>379</i>	

<b>GEOLOGIC DATA (Office Use Only)</b>			
Surface Elev.	Geologic Unit	Unit Thickness	Depth to Top
Subs. SWL	Date	Analysis	Aquifer Test
Driller's Remarks <i>See back.</i>			

DESCRIPTION OF FORMATIONS ENCOUNTERED	FROM	TO	FORMATIONS (Continued)	FROM	TO
<i>Clay</i>	<i>0</i>	<i>14</i>	<b>RECEIVED</b>  NOV 16 1987  Department of Natural Resources Bureau of Land & Water Resources		
<i>sd</i>	<i>14</i>	<i>45</i>			
<i>Clay</i>	<i>45</i>	<i>86</i>			
<i>sd</i>	<i>86</i>	<i>95</i>			
<i>Clay - silt</i>	<i>95</i>	<i>190</i>			
<i>red sd</i>	<i>190</i>	<i>220</i>			
<i>Clay - silt</i>	<i>220</i>	<i>355</i>			
<i>med sd</i>	<i>355</i>	<i>376</i>			
<i>Coarse sd</i>	<i>376</i>	<i>399</i>			

IF MORE SPACE IS NEEDED, USE BACK

If well telescopes please sketch and show depths.

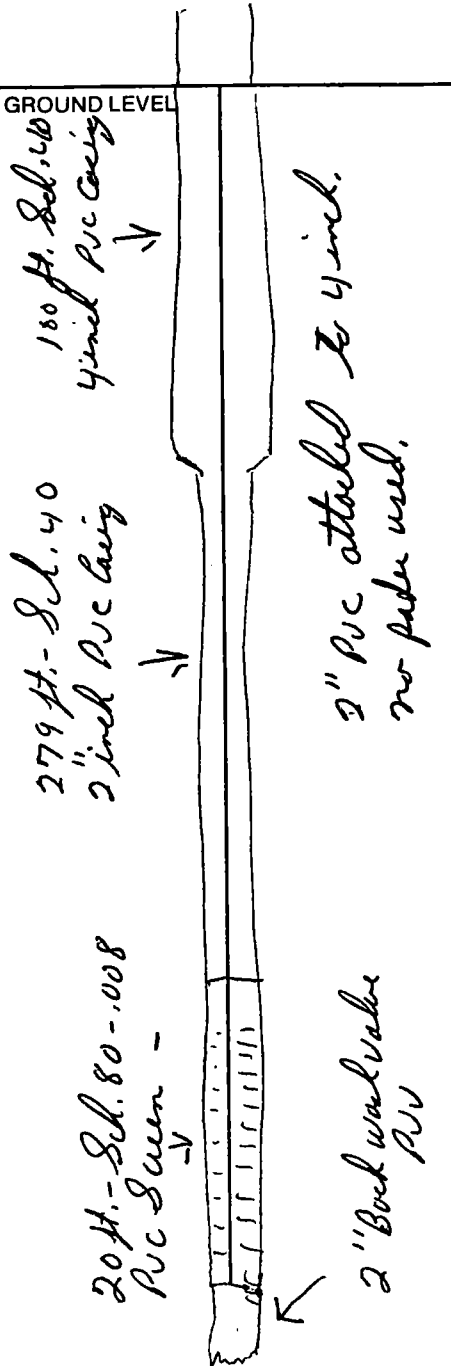

If more than one screen, show location of each on sketch.

	X		

SECTION 30

Please indicate well location X.

ADDITIONAL INFORMATION

Had a +3 water level.  
Well flowed approx. 4  
G.P.M.