

# MISSISSIPPI DEPARTMENT OF NATURAL RESOURCES

Bureau of Land and Water Resources

P.O. Box 10631

Jackson, Mississippi 39209

## WATER WELL DRILLERS LOG

COUNTY WELL LOCATED <i>Hancock</i>	
WELL NUMBER <i>R 2729</i>	CODED
DATE WELL COMPLETED <i>Sept. 29, 1987</i>	

PERMIT NUMBER
NAME OF DRILLING FIRM <i>Woodwell Dr.</i>
<i>Box 350C, B.S., Ms</i>

NAME & MAILING ADDRESS OF LANDOWNER <i>Elaine Roberts</i>			
<i>Coral St.</i>			
<i>Box St. Sain, ms.</i>			
WELL LOCATION:	SEC	TOWNSHIP	RANGE
	<i>33</i>	<i>8 N</i>	<i>14 E</i>
DISTANCE	DIRECTION		NEAREST TOWN
<i>1 1/2</i> Miles	<i>N</i>		<i>Wardlaw</i>
OTHER LANDMARK <i>Shoreline Park Sundeck</i>			
WELL PURPOSE: Home, Irrigation, Municipal, Industrial, Fish Pond, etc. <i>Home</i>			

PUMP DATA		
PUMP TYPE (Circle One): Submersible, Turbine, <u>Jet</u> Flowing Well, Other (Describe) _____		
POWER TYPE (Circle One): <u>Electric</u> Tractor, Diesel, Gasoline, Butane, Other (Describe) _____		
Pump Capacity (GPM) <i>10</i>	No. of Stages <i>1</i>	Setting Depth _____ FT.
PUMP TEST		
Well yielded _____ GPM with a drawdown of _____ ft. after _____ hours of pumping		

WELL DATA		
Well Depth <i>173 ft.</i>	Casing Diameter (In.) <i>2"</i>	Casing Length (Ft.) <i>163 ft.</i>
Type of Casing <i>8.40 PVC</i>	Hole Depth <i>173 ft.</i>	Depth to Static Water Level <i>-12 ft.</i>
TYPE OF COMPLETION: (Circle One or More): Gravel Packed, Underreamed, Telescoped, Natural Development, Open Hole, <u>Other</u> (Describe) <i>Badrush - Air</i>		
Top of Lap Pipe or Reduction in Casing _____ FEET IF TELESKOPED OR MORE THAN ONE SCREEN: USE BACK PAGE		

LOG DATA	
TYPE OF LOG RUN (Circle One): Electric, Gamma Ray, Density, Sonic, <u>No Log Run</u> , Other (Describe) _____	
Name of Organization Running Log <i>N/A</i>	

SCREEN DATA		
Diameter - Inches <i>2"</i>	Length - Feet <i>10 ft.</i>	Slot Size - Inches <i>1008</i>
Screen Type <i>80.80 PVC</i>	Depth to Bottom - Feet <i>173</i>	


GEOLOGIC DATA (Office Use Only)			
Surface Elev.	Geologic Unit	Unit Thickness	Depth to Top
Subs. SWL	Date	Analysis	Aquifer Test
Driller's Remarks <i>N/A</i>			

DESCRIPTION OF FORMATIONS ENCOUNTERED	FROM	TO
<i>clay</i>	<i>0</i>	<i>15</i>
<i>sd</i>	<i>15</i>	<i>47</i>
<i>clay</i>	<i>47</i>	<i>80</i>
<i>sd</i>	<i>80</i>	<i>96</i>
<i>clay - silt</i>	<i>96</i>	<i>154</i>
<i>sd - thin bedded</i>	<i>154</i>	<i>173</i>

FORMATIONS (Continued)		FROM	TO
<div style="border: 2px solid black; padding: 10px; text-align: center;"> <h1>RECEIVED</h1> <p>NOV 16 1987</p> <p>Department of Natural Resources Bureau of Land &amp; Water Resources</p> </div>			
IF MORE SPACE IS NEEDED, USE BACK			

If well telescopes please  
sketch and show depths.

GROUND LEVEL

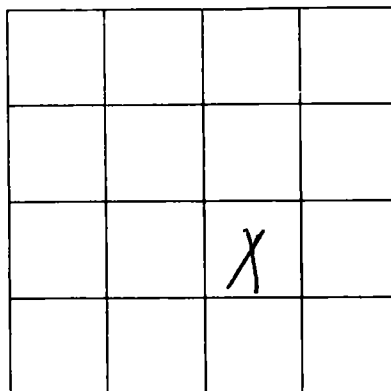

SECTION 33

Please indicate well location X.

ADDITIONAL INFORMATION

If more than one screen,  
show location of each on sketch.