

MISSISSIPPI DEPARTMENT OF NATURAL RESOURCES
Bureau of Land and Water Resources

P.O. Box 10631
Jackson, Mississippi 39209
WATER WELL DRILLERS LOG

COUNTY WELL LOCATED <i>Hancock</i>	
WELL NUMBER <i>K2731</i>	CODED
DATE WELL COMPLETED <i>Oct. 2, 1987</i>	

PERMIT NUMBER
NAME OF DRILLING FIRM <i>Wood Well Dlg</i>
<i>H.2 Box 350 C 9 St. m.</i>

NAME & MAILING ADDRESS OF LANDOWNER <i>Claudia M. Sauson</i>			
<i>East Granada</i>			
<i>Bay St. Louis m.</i>			
WELL LOCATION: SEC	TOWNSHIP	RANGE	
<i>6</i>	<i>8 N</i>	<i>14 E</i>	
DISTANCE	DIRECTION	NEAREST TOWN	
<i>6</i> Miles	<i>W</i>	<i>Waveland</i>	
OTHER LANDMARK <i>Bayside Park Sucks</i>			
WELL PURPOSE: Home, Irrigation, Municipal, Industrial, Fish Pond, etc. <i>Home</i>			

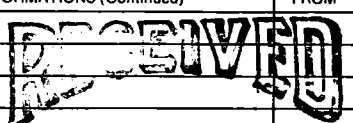
PUMP DATA		
PUMP TYPE (Circle One): Submersible, Turbine, Jet, Flowing Well, Other (Describe) <u><i>owner</i></u>		
POWER TYPE (Circle One): Electric, Tractor, Diesel, Gasoline, Butane, Other (Describe) _____		
Pump Capacity (GPM)	No. of Stages	Setting Depth FT.
PUMP TEST		
Well yielded _____ GPM with a drawdown of _____ ft. after _____ hours of pumping		

WELL DATA		
Well Depth <i>290 ft.</i>	Casing Diameter (In.) <i>2"</i>	Casing Length (Ft.) <i>280 ft.</i>
Type of Casing <i>Sk. 40 PVC</i>	Hole Depth <i>290 ft.</i>	Depth to Static Water Level <i>- 12 ft.</i>
TYPE OF COMPLETION (Circle One or More): Gravel Packed, Underreamed, Telescoped, Natural Development, Open Hole, Other (Describe) <i>Backwash - an</i> <input checked="" type="radio"/>		
Top of Lap Pipe or Reduction in Casing FEET IF TELESCOPED OR MORE THAN ONE SCREEN: USE BACK PAGE		

LOG DATA	
TYPE OF LOG RUN (Circle One): Electric, Gamma Ray, Density, Sonic, <input checked="" type="radio"/> No Log Run , Neutron, Other (Describe) _____	
Name of Organization Running Log	

SCREEN DATA		
Diameter - Inches <i>2"</i>	Length - Feet <i>10 ft.</i>	Slot Size - Inches <i>.008</i>
Screen Type <i>Sk. 80 PVC</i>	Depth to Bottom - Feet <i>- 290</i>	

GEOLOGIC DATA (Office Use Only)			
Surface Elev.	Geologic Unit	Unit Thickness	Depth to Top
Subs. SWL	Date	Analysis	Aquifer Test
Driller's Remarks <i>Replacement well. old well capped.</i>			

DESCRIPTION OF FORMATIONS ENCOUNTERED	FROM	TO	FORMATIONS (Continued)	FROM	TO
<i>clay sd</i>	<i>0</i>	<i>12</i>	 NOV 16 1987 Department of Natural Resources Bureau of Land & Water Resources		
<i>clay</i>	<i>12</i>	<i>44</i>			
<i>clay</i>	<i>44</i>	<i>95</i>			
<i>gsd</i>	<i>95</i>	<i>128</i>			
<i>clay</i>	<i>128</i>	<i>160</i>			
<i>Red gravel</i>	<i>160</i>	<i>165</i>			
<i>clay-silt</i>	<i>165</i>	<i>260</i>			
<i>coke sd</i>	<i>260</i>	<i>290</i>			

IF MORE SPACE IS NEEDED, USE BACK

If well telescopes please sketch and show depths.

GROUND LEVEL

		X	

SECTION 6

Please indicate well location X.

ADDITIONAL INFORMATION

If more than one screen,
show location of each on sketch.