

# MISSISSIPPI DEPARTMENT OF NATURAL RESOURCES

Bureau of Land and Water Resources

P.O. Box 10631

Jackson, Mississippi 39209

WATER WELL DRILLERS LOG

COUNTY WELL LOCATED <i>Hancock</i>
WELL NUMBER (UNPROVED) <i>K 273P</i>
DATE WELL COMPLETED <i>10-2-87</i>

PERMIT NUMBER
NAME OF DRILLING FIRM <i>Ward Well Dlg</i>
<i>Rt. 2 Box 350 C B.S.T. Ms.</i>

NAME & MAILING ADDRESS OF LANDOWNER <i>Jerry Moore East Granada Bay St. Louis ms.</i>			
WELL LOCATION: SEC	TOWNSHIP	RANGE	
<i>6</i>	<i>8</i>	<i>14</i>	<i>E</i>
DISTANCE	DIRECTION	NEAREST TOWN	
<i>6</i> Miles	<i>W</i>	of <i>Warland</i>	
OTHER LANDMARK <i>Bay Side Park Indv.</i>			
WELL PURPOSE: Home, Irrigation, Municipal, Industrial, Fish Pond, etc. <i>Home</i>			

PUMP DATA		
PUMP TYPE (Circle One): Submersible, Turbine, <b>Jet</b> Flowing Well, Other (Describe) _____		
POWER TYPE (Circle One): <b>Electric</b> Tractor, Diesel, Gasoline, Butane, Other (Describe) _____		
Pump Capacity (GPM)	No. of Stages	Setting Depth
<i>10</i>	<i>1</i>	<i>FT.</i>
PUMP TEST		
Well yielded _____ GPM with a drawdown of _____ ft. after _____ hours of pumping		

WELL DATA		
Well Depth <i>170ft.</i>	Casing Diameter (In.) <i>2"</i>	Casing Length (Ft.) <i>160ft.</i>
Type of Casing <i>Sch. 40 PVC</i>	Hole Depth <i>170ft.</i>	Depth to Static Water Level <i>-12ft.</i>
TYPE OF COMPLETION (Circle One or More): Gravel Packed, Underreamed, Telescoped, Natural Development, Open Hole, <b>Other</b> (Describe) <i>Backwash - air</i>		
Top of Lap Pipe or Reduction in Casing		
FEET	IF TELESCOPED OR MORE THAN ONE SCREEN: USE BACK PAGE	

LOG DATA	
TYPE OF LOG RUN (Circle One): Electric, Gamma Ray, Density, Sonic, <b>No Log Run</b> , Other (Describe) _____	
Name of Organization Running Log <i>N/A</i>	


SCREEN DATA		
Diameter - Inches <i>2"</i>	Length - Feet <i>10ft.</i>	Slot Size - Inches <i>1008</i>
Screen Type <i>Sch. 80 PVC</i>	Depth to Bottom - Feet <i>170</i>	

GEOLOGIC DATA (Office Use Only)			
Surface Elev.	Geologic Unit	Unit Thickness	Depth to Top
Subs. SWL	Date	Analysis	Aquifer Test
Driller's Remarks <i>N/A</i>			

DESCRIPTION OF FORMATIONS ENCOUNTERED	FROM	TO	FORMATIONS (Continued)	FROM	TO
<i>Silt - clay</i>	<i>0</i>	<i>12</i>	<b>RECEIVED</b>  DEC 17 1987		
<i>sd</i>	<i>12</i>	<i>45</i>			
<i>clay w/ shell</i>	<i>45</i>	<i>96</i>			
<i>sd</i>	<i>96</i>	<i>132</i>			
<i>clay - silt</i>	<i>132</i>	<i>158</i>			
<i>sd - silt &amp; gravel</i>	<i>158</i>	<i>170</i>			
			Department of Natural Resources Bureau of Land & Water Resources		
IF MORE SPACE IS NEEDED, USE BACK					

If well telescopes please sketch and show depths.

GROUND LEVEL

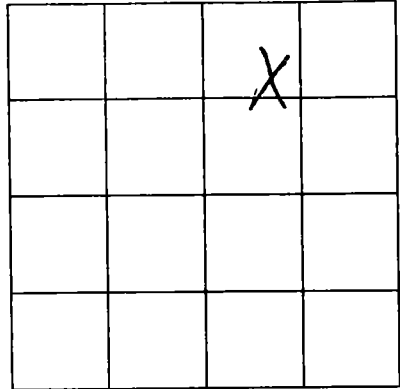

SECTION 6

Please indicate well location X.

ADDITIONAL INFORMATION

Lined area for additional information.

If more than one screen, show location of each on sketch.