

MISSISSIPPI DEPARTMENT OF NATURAL RESOURCES
Bureau of Land and Water Resources

P.O. Box 10631

Jackson, Mississippi 39209

WATER WELL DRILLERS LOG

COUNTY WELL LOCATED <i>Hancock</i>	
WELL NUMBER <i>R 2733</i>	CODED
DATE WELL COMPLETED <i>10-6-87</i>	

PERMIT NUMBER
NAME OF DRILLING FIRM <i>Wood Well Drilling</i>
<i>Rt. 2, Box 350C, BSL, ms</i>

NAME & MAILING ADDRESS OF LANDOWNER <i>Judy Walker</i>		
<i>Mediterranean St.</i>		
<i>Bay St. Louis ms.</i>		
WELL LOCATION: SEC	TOWNSHIP	RANGE
<i>28</i>	<i>S</i>	<i>14</i>
DISTANCE	DIRECTION	NEAREST TOWN
<i>2</i> Miles	<i>N</i>	<i>Waveland</i>
OTHER LANDMARK <i>Shoreline Park Sucker</i>		
WELL PURPOSE: Home, Irrigation, Municipal, Industrial, Fish Pond, etc. <i>Home</i>		

PUMP DATA		
PUMP TYPE (Circle One): Submersible, Turbine, Jet, Flowing Well, Other (Describe) <u><i>owner</i></u>		
POWER TYPE (Circle One): Electric, Tractor, Diesel, Gasoline, Butane, Other (Describe) _____		
Pump Capacity (GPM)	No. of Stages	Setting Depth FT.
PUMP TEST		
Well yielded _____ GPM with a drawdown of _____ ft. after _____ hours of pumping		

WELL DATA		
Well Depth <i>150 ft.</i>	Casing Diameter (in.) <i>2"</i>	Casing Length (ft.) <i>140 ft.</i>
Type of Casing <i>Sk. 40 pc</i>	Hole Depth <i>150</i>	Depth to Static Water Level <i>-9 ft.</i>
TYPE OF COMPLETION: (Circle One or More): Gravel Packed, Underreamed, Telescoped, Natural Development, Open Hole, Other (Describe) <i>Backwash - air</i>		
Top of Lap Pipe or Reduction in Casing FEET <input type="checkbox"/> IF TELESCOPED OR MORE THAN ONE SCREEN: USE BACK PAGE		

LOG DATA	
TYPE OF LOG RUN (Circle One): <u><i>No Log Run</i></u> Electric, Gamma Ray, Density, Sonic, Neutron, Other (Describe) _____	
Name of Organization Running Log	

SCREEN DATA		
Diameter - Inches <i>2"</i>	Length - Feet <i>10 ft.</i>	Slot Size - Inches <i>1.008</i>
Screen type <i>Sk. 80 PVC</i>	Depth to Bottom - Feet <i>750</i>	

GEOLOGIC DATA (Office Use Only)			
Surface Elev.	Geologic Unit	Unit Thickness	Depth to Top
Subs. SWL	Date	Analysis	Aquifer Test


Driller's Remarks

DESCRIPTION OF FORMATIONS ENCOUNTERED	FROM	TO	FORMATIONS (Continued)	
			FROM	TO
<i>Sandy Soil</i>	<i>0</i>	<i>3</i>		
<i>Clay</i>	<i>3</i>	<i>18</i>		
<i>Sd</i>	<i>18</i>	<i>42</i>		
<i>Clay</i>	<i>42</i>	<i>84</i>		
<i>Sd</i>	<i>84</i>	<i>112</i>		
<i>Coarse Sc</i>	<i>112</i>	<i>150</i>		

IF MORE SPACE IS NEEDED, USE BACK

If well telescopes please
sketch and show depths.

GROUND LEVEL

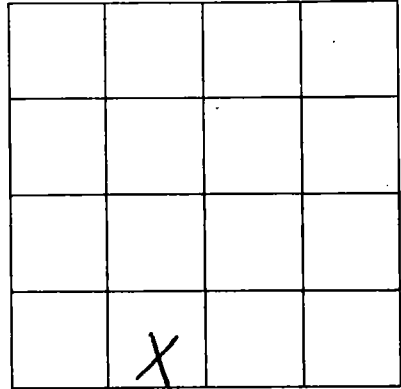

SECTION 2P

Please indicate well location X.

ADDITIONAL INFORMATION

If more than one screen,
show location of each on sketch.