

MISSISSIPPI DEPARTMENT OF NATURAL RESOURCES

Bureau of Land and Water Resources

P.O. Box 10631

Jackson, Mississippi 39209

WATER WELL DRILLERS LOG

COUNTY WELL LOCATED <i>Warren</i>	
WELL NUMBER <i>R2738</i>	CODED
DATE WELL COMPLETED <i>11-6-87</i>	

PERMIT NUMBER
NAME OF DRILLING FIRM <i>Wood Well Drilling</i>
<i>P.O. Box 3500, P. S. S. Ms.</i>

NAME & MAILING ADDRESS OF LANDOWNER <i>Tramm Good</i>			
<i>East Granada St</i>			
<i>Bay St. Louis, Ms.</i>			
WELL LOCATION: SEC	TOWNSHIP	RANGE	
<i>6</i>	<i>8</i>	<i>N 14 E</i>	
DISTANCE	DIRECTION	NEAREST TOWN	
<i>7</i> Miles	<i>W</i>	of <i>Warren</i>	
OTHER LANDMARK <i>Bayside Park Subv.</i>			
WELL PURPOSE: Home, Irrigation, Municipal, Industrial, Fish Pond, etc. <i>Home</i>			

PUMP DATA		
PUMP TYPE (Circle One): Submersible, Turbine, Jet, Flowing Well, Other (Describe) <u><i>owner</i></u>		
POWER TYPE (Circle One): Electric, Tractor, Diesel, Gasoline, Butane, Other (Describe) _____		
Pump Capacity (GPM)	No. of Stages	Setting Depth FT.
PUMP TEST		
Well yielded _____ GPM with a drawdown of _____ ft. after _____ hours of pumping		

WELL DATA		
Well Depth <i>170 ft.</i>	Casing Diameter (In.) <i>2"</i>	Casing Length (Ft.) <i>160 ft.</i>
Type of Casing <i>Sh. PVC</i>	Hole Depth <i>170 ft.</i>	Depth to Static Water Level <i>- 12 ft.</i>
TYPE OF COMPLETION (Circle One or More): Gravel Packed, Underreamed, Telescoped, Natural Development, Open Hole, <u><i>Other</i></u> (Describe) <i>Bed Wash - air</i>		
Top of Lap Pipe or Reduction in Casing FEET IF TELESCOPED OR MORE THAN ONE SCREEN: USE BACK PAGE		

LOG DATA	
TYPE OF LOG RUN (Circle One): Electric, Gamma Ray, Density, Sonic, Neutron, Other (Describe) _____	
<u><i>No Log Run</i></u>	
Name of Organization Running Log	

SCREEN DATA		
Diameter - Inches <i>2"</i>	Length - Feet <i>10 ft.</i>	Slot Size - Inches <i>.008</i>
Screen Type <i>Sch. 80 PVC</i>	Depth to Bottom - Feet <i>-170</i>	

GEOLOGIC DATA (Office Use Only)			
Surface Elev.	Geologic Unit	Unit Thickness	Depth to Top
Subs. SWL	Date	Analysis	Aquifer Test


Driller's Remarks <i>U/M</i>

DESCRIPTION OF FORMATIONS ENCOUNTERED	FROM	TO	FORMATIONS (Continued)	FROM	TO
<i>Clay</i>	<i>0</i>	<i>12</i>			
<i>SSC</i>	<i>12</i>	<i>48</i>			
<i>Clay</i>	<i>48</i>	<i>55</i>			
<i>SS</i>	<i>55</i>	<i>128</i>			
<i>Clay-silt</i>	<i>128</i>	<i>147</i>			
<i>SS - fine sand</i>	<i>147</i>	<i>170</i>			

IF MORE SPACE IS NEEDED, USE BACK

If well telescopes please
sketch and show depths.

GROUND LEVEL

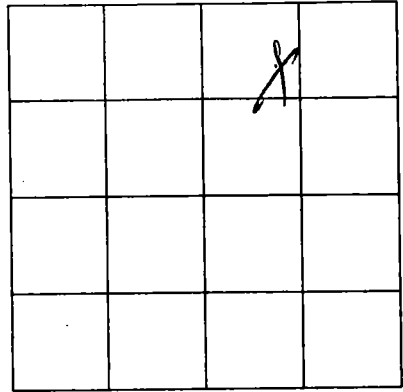

SECTION 6

Please indicate well location X.

ADDITIONAL INFORMATION

Lined area for additional information.

If more than one screen,
show location of each on sketch.