

MISSISSIPPI DEPARTMENT OF NATURAL RESOURCES

Bureau of Land and Water Resources

P.O. Box 10631

Jackson, Mississippi 39209

WATER WELL DRILLERS LOG

COUNTY WELL LOCATED <i>Hancock</i>	
WELL NUMBER <i>K 2939</i>	CODED
DATE WELL COMPLETED <i>11-11-87</i>	

PERMIT NUMBER
NAME OF DRILLING FIRM <i>Woodwell Drilling</i>
<i>Attn: Roy Soc, B.S. Inc.</i>

NAME & MAILING ADDRESS OF LANDOWNER <i>Jay Mike</i>		
<i>Nassau St.</i>		
<i>Bay St. Louis ms.</i>		
WELL LOCATION: SEC	TOWNSHIP	RANGE
<i>39</i>	<i>8</i>	<i>N 14 W</i>
DISTANCE	DIRECTION	NEAREST TOWN
<i>6</i> Miles	<i>N</i>	<i>Waveland</i>
OTHER LANDMARK <i>Shoreline Park Sude.</i>		
WELL PURPOSE: Home, Irrigation, Municipal, Industrial, Fish Pond, etc. <i>Home</i>		


PUMP DATA		
PUMP TYPE (Circle One): Submersible, Turbine, Jet, Flowing Well, Other (Describe) <u><i>Other</i></u>		
POWER TYPE (Circle One): Electric, Tractor, Diesel, Gasoline, Butane, Other (Describe) _____		
Pump Capacity (GPM)	No. of Stages	Setting Depth FT.
PUMP TEST		
Well yielded _____ GPM with a drawdown of _____ ft. after _____ hours of pumping		

WELL DATA		
Well Depth <i>175 ft.</i>	Casing Diameter (In.) <i>2"</i>	Casing Length (Ft.) <i>165 ft.</i>
Type of Casing <i>Sch. 40 pvc</i>	Hole Depth <i>175 ft.</i>	Depth to Static Water Level <i>- 9 ft.</i>
TYPE OF COMPLETION: (Circle One or More): Gravel Packed, Underreamed, Telescoped, Natural Development, Open Hole, <input checked="" type="radio"/> Other (Describe) <i>Backward - air</i>		
Top of Lap Pipe or Reduction in Casing		
FEET	IF TELESCOPED OR MORE THAN ONE SCREEN: USE BACK PAGE	

LOG DATA	
TYPE OF LOG RUN (Circle One): Electric, Gamma Ray, Density, Sonic, <input checked="" type="radio"/> No Log Run, Neutron, Other (Describe) _____	
Name of Organization Running Log	


SCREEN DATA		
Diameter - Inches <i>2"</i>	Length - Feet <i>10 ft.</i>	Slot Size - Inches <i>.008</i>
Screen # type <i>Sch. 80 pvc</i>	Depth to Bottom - Feet <i>175</i>	

GEOLOGIC DATA (Office Use Only)			
Surface Elev.	Geologic Unit	Unit Thickness	Depth to Top
Subs. SWL	Date	Analysis	Aquifer Test
Driller's Remarks <i>N/A</i>			

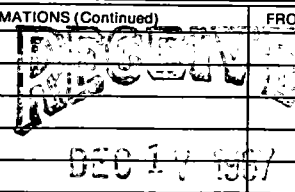DESCRIPTION OF FORMATIONS ENCOUNTERED	FROM	TO	FORMATIONS (Continued)	FROM	TO
<i>Fill - clay</i>	<i>0</i>	<i>18</i>			
<i>sd</i>	<i>18</i>	<i>52</i>			
<i>clay</i>	<i>52</i>	<i>106</i>			
<i>fine sd</i>	<i>106</i>	<i>115</i>			
<i>clay - silt</i>	<i>115</i>	<i>162</i>			
<i>med. cone sd</i>	<i>162</i>	<i>175</i>			
			Department of Natural Resources Bureau of Land & Water Resources		
IF MORE SPACE IS NEEDED, USE BACK					

If well telescopes please
sketch and show depths.

GROUND LEVEL

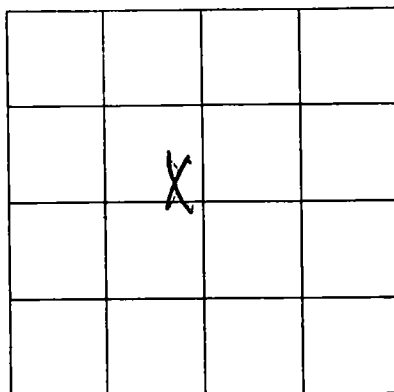

SECTION 39

Please indicate well location X.

ADDITIONAL INFORMATION

If more than one screen,
show location of each on sketch.