

MISSISSIPPI DEPARTMENT OF NATURAL RESOURCES
Bureau of Land and Water Resources

P.O. Box 10631

Jackson, Mississippi 39209

WATER WELL DRILLERS LOG

COUNTY WELL LOCATED
N Hancock

WELL NUMBER CODED
K 2143

DATE WELL COMPLETED
12-22-87

PERMIT NUMBER

NAME OF DRILLING FIRM
WARD WELL DLG.

Rt. 2, Bx. 350C, BSL, MS

NAME & MAILING ADDRESS OF LANDOWNER
Louis Sherryfelt

Ocean St.

Bay St. Louis ms.

WELL LOCATION: SEC TOWNSHIP RANGE
33 8 S 14 E

DISTANCE DIRECTION NEAREST TOWN
1/2 Miles *N* of *Wareland*

OTHER LANDMARK
Shoreline Park Sudev.

WELL PURPOSE: Home, Irrigation, Municipal, Industrial, Fish Pond, etc.
Home

PUMP DATA

PUMP TYPE (Circle One):
Submersible, Turbine, Jet, Flowing Well,
Other (Describe) *owner*

POWER TYPE (Circle One):
Electric, Tractor, Diesel, Gasoline, Butane,
Other (Describe)

Pump Capacity (GPM) No. of Stages Setting Depth FT.

PUMP TEST
Well yielded _____ GPM with
a drawdown of _____ ft.
after _____ hours of pumping

WELL DATA

Well Depth Casing Diameter (In.) Casing Length (Ft.)
175' 2" 165'

Type of Casing Hole Depth Depth to Static Water Level
Sh. 40 PVC 175' -10 ft.

TYPE OF COMPLETION: (Circle One or More):
Gravel Packed, Underreamed, Telescoped,
Natural Development, Open Hole, Other
(Describe) *Backwashed - air pumped*

Top of Lap Pipe or Reduction in Casing

FEET IF TELESCOPED OR MORE THAN ONE SCREEN: USE BACK PAGE

LOG DATA

TYPE OF LOG RUN (Circle One):
Electric, Gamma Ray, Density, Sonic, *No Log Run*, Neutron,
Other (Describe)

Name of Organization Running Log

GEOLOGIC DATA (Office Use Only)

Surface Elev.	Geologic Unit	Unit Thickness	Depth to Top
Subs. SWL	Date	Analysis	Aquifer Test

Driller's Remarks

N/A

SCREEN DATA


Diameter - Inches Length - Feet Slot Size - Inches
2" 10' .008

Screen Type Depth to Bottom - Feet
Sh. 80 PVC -175

DESCRIPTION OF FORMATIONS ENCOUNTERED	FROM	TO	FORMATIONS (Continued)	FROM	TO
<i>clay</i>	<i>0</i>	<i>15</i>	RECEIVED	FEB 18 1988	
<i>psd</i>	<i>15</i>	<i>48</i>			
<i>clay</i>	<i>48</i>	<i>76</i>			
<i>course sd</i>	<i>76</i>	<i>86</i>			
<i>clay - silt</i>	<i>86</i>	<i>155</i>			
<i>course sd</i>	<i>155</i>	<i>175</i>			
			Department of Natural Resources Bureau of Land & Water Resources		
IF MORE SPACE IS NEEDED, USE BACK					

If well telescopes please sketch and show depths.

GROUND LEVEL

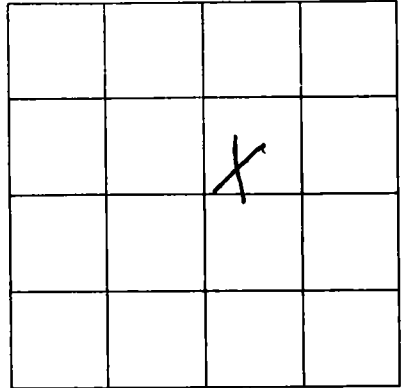

SECTION 33

Please indicate well location X.

ADDITIONAL INFORMATION

Lined area for additional information.

If more than one screen, show location of each on sketch.