

MISSISSIPPI DEPARTMENT OF NATURAL RESOURCES

Bureau of Land and Water Resources

P.O. Box 10631

Jackson, Mississippi 39209

WATER WELL DRILLERS LOG

COUNTY WELL LOCATED HANCOCK	
WELL NUMBER K 2758	CODED
DATE WELL COMPLETED JUNE 29, 1988	

PERMIT NUMBER
NAME OF DRILLING FIRM WARD WELL DLG.
RT. 2, BX. 350C, B.S.L.

NAME & MAILING ADDRESS OF LANDOWNER CARL WAMSLEY			
16 GOOD ST.			
BAY ST. LOUIS MS.			
WELL LOCATION:	SEC	TOWNSHIP	RANGE
	37	8 N	14 E
DISTANCE	DIRECTION	NEAREST TOWN	
2 Miles	N/W of	B.S.L.	
OTHER LANDMARK -			
WELL PURPOSE: Home, Irrigation, Municipal, Industrial, Fish Pond, etc. HOME			

PUMP DATA		
PUMP TYPE (Circle One): Submersible, Turbine, <input checked="" type="radio"/> Jet, <input checked="" type="radio"/> Flowing Well, Other (Describe) _____		
POWER TYPE (Circle One): <input checked="" type="radio"/> Electric, Tractor, Diesel, Gasoline, Butane, Other (Describe) OWNERS		
Pump Capacity (GPM)	No. of Stages	Setting Depth FT.
PUMP TEST		
Well yielded _____ GPM with a drawdown of _____ ft. after _____ hours of pumping		

WELL DATA		
Well Depth 546 FT.	Casing Diameter (In.) 2"	Casing Length (Ft.) 526
Type of Casing PVC	Hole Depth 546	Depth to Static Water Level +5
TYPE OF COMPLETION: (Circle One or More): Gravel Packed, Underreamed, Telescoped, Natural Development, Open Hole, Other (Describe) BACKWASH - AIR		
Top of Lap Pipe or Reduction in Casing FEET IF TELESCOPED OR MORE THAN ONE SCREEN: USE BACK PAGE		

LOG DATA	
TYPE OF LOG RUN (Circle One): Electric, Gamma Ray, Density, Sonic, Neutron, Other (Describe) <input checked="" type="radio"/> No Log Run	
Name of Organization Running Log /	

SCREEN DATA		
Diameter - Inches 2"	Length - Feet 20	Slot Size - Inches 1008
Screen Type SCH. 80 PVC	Depth to Bottom - Feet -546	

GEOLOGIC DATA (Office Use Only)			
Surface Elev.	Geologic Unit	Unit Thickness	Depth to Top
Subs. SWL	Date	Analysis	Aquifer Test


Driller's Remarks WELL FLOWING 12 GPM.

DESCRIPTION OF FORMATIONS ENCOUNTERED	FROM	TO
FILL-CLAY	0	18
SD	18	56
CLAY	56	75
GRAVEL	75	84
CLAY	84	105
SD	105	147
CLAY-SILT	147	420
SD-FINE	420	438
SD-SILT	438	495
CORSE SD	495	546

RECEIVED	
OCT 26 1988	
Department of Natural Resources Bureau of Land & Water Resources	
IF MORE SPACE IS NEEDED, USE BACK	

If well telescopes please sketch and show depths.

GROUND LEVEL

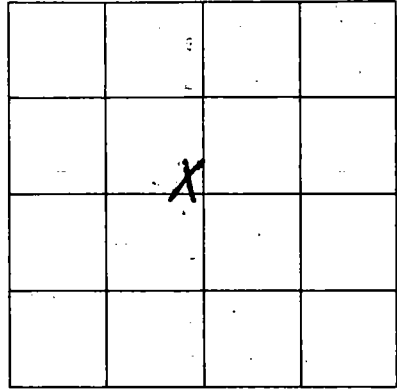

SECTION 37

Please indicate well location X.

ADDITIONAL INFORMATION

If more than one screen,
show location of each on sketch.