

MISSISSIPPI DEPARTMENT OF NATURAL RESOURCES

Bureau of Land and Water Resources

P.O. Box 10631

Jackson, Mississippi 39209

WATER WELL DRILLERS LOG

COUNTY WELL LOCATED <i>Hancock</i>	
WELL NUMBER <i>K 8775</i>	CODED
DATE WELL COMPLETED <i>4-28-89</i>	

PERMIT NUMBER
NAME OF DRILLING FIRM <i>Woodwell Dr</i>
<i>At 2, Bay 350C, B.S.I.</i>

NAME & MAILING ADDRESS OF LANDOWNER <i>John Potter</i> <i>West Clay</i> <i>Bay St. Louis ms.</i>			
WELL LOCATION:	SEC	TOWNSHIP	RANGE
	<i>6</i>	<i>9</i>	<i>14</i>
DISTANCE	DIRECTION	NEAREST TOWN	
<i>6.5</i> Miles	<i>W</i>	<i>Woodwell</i>	
OTHER LANDMARK <i>Bay Side Park Subd.</i>			
WELL PURPOSE: Home, Irrigation, Municipal, Industrial, Fish Pond, etc. <i>Home</i>			

PUMP DATA		
PUMP TYPE (Circle One): Submersible, Turbine, Jet, Flowing Well, Other (Describe) <u><i>Diener</i></u>		
POWER TYPE (Circle One): Electric, Tractor, Diesel, Gasoline, Butane, Other (Describe) _____		
Pump Capacity (GPM)	No. of Stages	Setting Depth FT.
PUMP TEST		
Well yielded _____ GPM with a drawdown of _____ ft. after _____ hours of pumping		

WELL DATA		
Well Depth <i>165'</i>	Casing Diameter (In.) <i>2"</i>	Casing Length (Ft.) <i>155'</i>
Type of Casing <i>Dr. 40 PVC</i>	Hole Depth <i>165'</i>	Depth to Static Water Level <i>-11'</i>
TYPE OF COMPLETION: (Circle One or More): Gravel Packed, Underreamed, Telescoped, Natural Development, Open Hole, <u><i>Other</i></u> (Describe) <i>Backwash - air</i>		
Top of Lap Pipe or Reduction in Casing FEET <input type="checkbox"/> IF TELESCOPED OR MORE THAN ONE SCREEN: USE BACK PAGE		

LOG DATA	
TYPE OF LOG RUN (Circle One): Electric, Gamma Ray, Density, Sonic, <u><i>No Log Run</i></u> , Neutron, Other (Describe) _____	
Name of Organization Running Log	

SCREEN DATA		
Diameter - Inches <i>2"</i>	Length - Feet <i>10'</i>	Slot Size - Inches <i>.008</i>
Screen Type <i>Sch. 80 PVC</i>	Depth to Bottom - Feet <i>165</i>	

GEOLOGIC DATA (Office Use Only)			
Surface Elev.	Geologic Unit	Unit Thickness	Depth to Top
Subs. SWL	Date	Analysis	Aquifer Test

Driller's Remarks <i>N/A</i>


RECEIVED

DESCRIPTION OF FORMATIONS ENCOUNTERED	FROM	TO
<i>Clay</i>	<i>0</i>	<i>15</i>
<i>sd</i>	<i>15</i>	<i>54</i>
<i>Clay</i>	<i>54</i>	<i>95</i>
<i>sd</i>	<i>95</i>	<i>132</i>
<i>Clay</i>	<i>132</i>	<i>150</i>
<i>comp sd +</i>		
<i>fine gravel</i>	<i>150</i>	<i>165</i>

FORMATS (Continued)	FROM	TO
	<i>JUN 16 1989</i>	
Department of Natural Resources Bureau of Land & Water Resources		
IF MORE SPACE IS NEEDED, USE BACK		

If well telescopes please sketch and show depths.

GROUND LEVEL

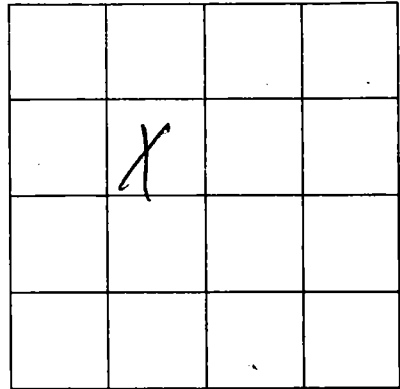

SECTION 6

Please indicate well location X.

ADDITIONAL INFORMATION

If more than one screen,
show location of each on sketch.