

MISSISSIPPI DEPARTMENT OF NATURAL RESOURCES

Bureau of Land and Water Resources

P.O. Box 10631

Jackson, Mississippi 39209

WATER WELL DRILLERS LOG

COUNTY WELL LOCATED
Hancock

WELL NUMBER
R2716

CODED

DATE WELL COMPLETED
4-2-89

PERMIT NUMBER

NAME OF DRILLING FIRM
Ward Well Dr.

Rt. 2, Box 3506, B.S.L.

NAME & MAILING ADDRESS OF LANDOWNER
Richard E. King
Willow St.
Harbor Estates

Box St. Louis Mrs.

WELL LOCATION: SEC *28* TOWNSHIP *8* RANGE *N 41 W 3*

DISTANCE *5* Miles *n/w* of *Waveland*

OTHER LANDMARK
Harbor Estates

WELL PURPOSE: Home, Irrigation, Municipal, Industrial, Fish Pond, etc.
Home

PUMP DATA

PUMP TYPE (Circle One):
Submersible, Turbines, Jet, Flowing Well,
Other (Describe) *Shallow well*

POWER TYPE (Circle One):
 Electric, Tractor, Diesel, Gasoline, Butane,
Other (Describe)

Pump Capacity (GPM) *12* No. of Stages *1* Setting Depth *12* FT.

PUMP TEST

Well yielded _____ GPM with
a drawdown of _____ ft.
after _____ hours of pumping

WELL DATA

Well Depth *118'* Casing Diameter (In.) *2"* Casing Length (Ft.) *108'*

Type of Casing *Sch. 40pc* Hole Depth *118'* Depth to Static Water Level *- 8'*

TYPE OF COMPLETION: (Circle One or More):
Gravel Packed, Underreamed, Telescoped,
Natural Development, Open Hole, Other
(Describe) *Backwash - air*

Top of Lap Pipe or Reduction in Casing

FEET IF TELESCOPED OR MORE THAN ONE SCREEN: USE BACK PAGE

LOG DATA

TYPE OF LOG RUN (Circle One):
Electric, Gamma Ray, Density, Sonic, No Log Run, Neutron,
Other (Describe)

Name of Organization Running Log

SCREEN DATA

Diameter - Inches *2"* Length - Feet *10'* Slot Size - Inches *.008*

Screen Type *Sch. 80 PVC* Depth to Bottom - Feet *-118*

GEOLOGIC DATA (Office Use Only)

Surface Elev.	Geologic Unit	Unit Thickness	Depth to Top
Subs. SWL	Date	Analysis	Aquifer Test

Driller's Remarks

DESCRIPTION OF FORMATIONS ENCOUNTERED	FROM	TO
<i>2M - Clay</i>	<i>0</i>	<i>15</i>
<i>sd</i>	<i>15</i>	<i>42</i>
<i>Clay</i>	<i>42</i>	<i>90</i>
<i>Coarse sd</i>	<i>90</i>	<i>118</i>

RECEIVED


JUN 16 1989

Department of Natural Resources
Bureau of Land & Water Resources

IF MORE SPACE IS NEEDED, USE BACK

If well telescopes please sketch and show depths.

GROUND LEVEL

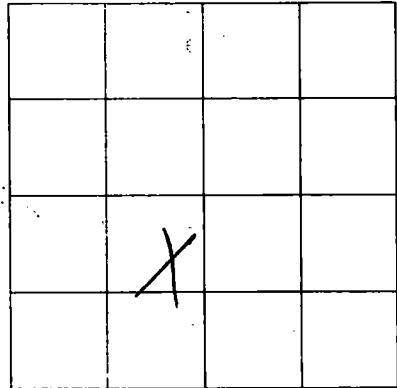

SECTION 29

Please indicate well location X.

ADDITIONAL INFORMATION

If more than one screen,
show location of each on sketch.