

**MISSISSIPPI DEPARTMENT OF NATURAL RESOURCES**  
Bureau of Land and Water Resources

P.O. Box 10631  
Jackson, Mississippi 39209  
**WATER WELL DRILLERS LOG**

COUNTY WELL LOCATED  
*Hancock*

WELL NUMBER CODED  
*R2780*

DATE WELL COMPLETED  
*3-13-89*

PERMIT NUMBER

NAME OF DRILLING FIRM  
*Wood Well Drg.*

*Rt. 2, Box 350C, B.S.L.*

NAME & MAILING ADDRESS OF LANDOWNER  
*Vernon Blackledge*

*Rt. 6, Box 603 J*

*Boy St. Louis, ms.*

WELL LOCATION: SEC \_\_\_\_\_ TOWNSHIP \_\_\_\_\_ RANGE \_\_\_\_\_

DISTANCE \_\_\_\_\_ DIRECTION \_\_\_\_\_ NEAREST TOWN \_\_\_\_\_

*4* Miles *N/E* of *Wardwood*

OTHER LANDMARK  
*Shoreline Park Sides*

WELL PURPOSE: Home, Irrigation, Municipal, Industrial, Fish Pond, etc.  
*Home*

**PUMP DATA**

PUMP TYPE (Circle One):  
Submersible, Turbine, Jet, Flowing Well,  
Other (Describe) *owner*

POWER TYPE (Circle One):  
Electric, Tractor, Diesel, Gasoline, Butane,  
Other (Describe) \_\_\_\_\_

Pump Capacity (GPM)	No. of Stages	Setting Depth
		FT.

PUMP TEST

Well yielded \_\_\_\_\_ GPM with  
a drawdown of \_\_\_\_\_ ft.  
after \_\_\_\_\_ hours of pumping

**WELL DATA**

Well Depth <i>149'</i>	Casing Diameter (In.) <i>2"</i>	Casing Length (Ft.) <i>139'</i>
Type of Casing <i>Sh. 40 PVC</i>	Hole Depth <i>149'</i>	Depth to Static Water Level <i>-8'</i>

TYPE OF COMPLETION: (Circle One or More):  
Gravel Packed, Underreamed, Telescoped,  
Natural Development, Open Hole,  Other  
(Describe) *Backwash - air*

Top of Lap Pipe or Reduction in Casing

FEET	IF TELESCOPED OR MORE THAN ONE SCREEN: USE BACK PAGE
------	--

**LOG DATA**

TYPE OF LOG RUN (Circle One):  No Log Run  
Electric, Gamma Ray, Density, Sonic, Neutron,  
Other (Describe) \_\_\_\_\_

Name of Organization Running Log \_\_\_\_\_

**SCREEN DATA**

Diameter - Inches <i>2"</i>	Length - Feet <i>10'</i>	Slot Size - Inches <i>.008</i>
Screen Type <i>Sch. 80 PVC</i>	Depth to Bottom - Feet <i>-149</i>	

**GEOLOGIC DATA (Office Use Only)**

Surface Elev.	Geologic Unit	Unit Thickness	Depth to Top
Subs. SWL	Date	Analysis	Aquifer Test

Driller's Remarks

DESCRIPTION OF FORMATIONS ENCOUNTERED	FROM	TO	FORMATION (Continued)	FROM	TO
<i>Fill - Clay</i>	<i>0</i>	<i>15</i>			
<i>sd</i>	<i>15</i>	<i>44</i>			
<i>Clay</i>	<i>44</i>	<i>82</i>			
<i>sd</i>	<i>82</i>	<i>91</i>			
<i>Clay</i>	<i>91</i>	<i>97</i>			
<i>Fine sd</i>	<i>97</i>	<i>112</i>			
<i>Clay</i>	<i>112</i>	<i>135</i>			
<i>med. sd.</i>	<i>135</i>	<i>149</i>			


**RECEIVED**  
JUN 16 1989

Department of Natural Resources  
Bureau of Land & Water Resources

IF MORE SPACE IS NEEDED, USE BACK

If well telescopes please sketch and show depths.

GROUND LEVEL

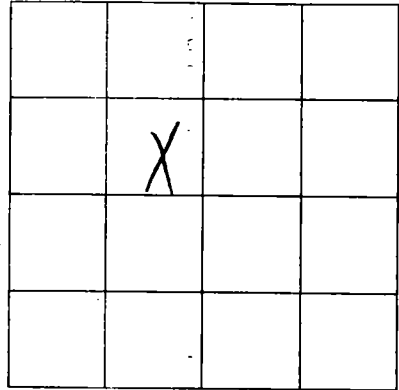

SECTION 40

Please indicate well location X.

ADDITIONAL INFORMATION

If more than one screen,  
show location of each on sketch.