

**MISSISSIPPI DEPARTMENT OF NATURAL RESOURCES**  
Bureau of Land and Water Resources

P.O. Box 10631  
Jackson, Mississippi 39209  
**WATER WELL DRILLERS LOG**

COUNTY WELL LOCATED <i>Hancock</i>		PERMIT NUMBER
WELL NUMBER <i>K2287</i>	CODED	
DATE WELL COMPLETED <i>May 12, 1989</i>		NAME OF DRILLING FIRM <i>Wood Well Dlg</i>
NAME & MAILING ADDRESS OF LANDOWNER <i>Norman Lehnen</i> <i>P.O. Box 619</i> <i>Bay St. Louis, Ms.</i>		

PUMP DATA		
PUMP TYPE (Circle One): Submersible, Turbine, Jet, Flowing Well, Other (Describe) <i>Crusher</i>		
POWER TYPE (Circle One): Electric, Tractor, Diesel, Gasoline, Butane, Other (Describe) _____		
Pump Capacity (GPM)	No. of Stages	Setting Depth _____ FT.
PUMP TEST		
Well yielded _____ GPM with a drawdown of _____ ft. after _____ hours of pumping		

WELL LOCATION: SEC _____ TOWNSHIP _____ RANGE _____			
<i>15</i> <i>9</i> <i>N</i> <i>14</i> <i>E</i>			
DISTANCE _____ Miles		DIRECTION _____ of _____	
NEAREST TOWN _____			
OTHER LANDMARK _____			
WELL PURPOSE: Home, Irrigation, Municipal, Industrial, Fish Pond, etc. <i>Home</i>			

WELL DATA		
Well Depth <i>315'</i>	Casing Diameter (In.) <i>2"</i>	Casing Length (Ft.) <i>305</i>
Type of Casing <i>Sch. 80 NC</i>	Hole Depth <i>315'</i>	Depth to Static Water Level <i>-12'</i>
TYPE OF COMPLETION: (Circle One or More): Gravel Packed, Underreamed, Telescoped, Natural Development, Open Hole, Other (Describe) <i>Backwash - air</i> <input checked="" type="checkbox"/> <i>Other</i>		
Top of Lap Pipe or Reduction in Casing _____ FEET		
IF TELESCOPED OR MORE THAN ONE SCREEN: USE BACK PAGE		


LOG DATA	
TYPE OF LOG RUN (Circle One): Electric, Gamma Ray, Density, Sonic, Neutron, Other (Describe) <i>No Log Run</i>	
Name of Organization Running Log _____	

SCREEN DATA		
Diameter - Inches <i>2</i>	Length - Feet <i>10</i>	Slot Size - Inches <i>.008</i>
Screen Type <i>Sch. 80 Duc</i>	Depth to Bottom - Feet <i>-315</i>	

GEOLOGIC DATA (Office Use Only)			
Surface Elev.	Geologic Unit	Unit Thickness	Depth to Top
Subs. SWL	Date	Analysis	Aquifer Test

Driller's Remarks

DESCRIPTION OF FORMATIONS ENCOUNTERED	FROM	TO	FORMATIONS (Continued)	TO
<i>Clay sd</i>	<i>0</i>	<i>14</i>		
<i>sd</i>	<i>14</i>	<i>52</i>		
<i>Clay</i>	<i>52</i>	<i>105</i>		
<i>Coarse sd</i>	<i>105</i>	<i>124</i>		
<i>Clay - silt</i>	<i>124</i>	<i>276</i>		
<i>Coarse sd</i>	<i>276</i>	<i>315</i>		
IF MORE SPACE IS NEEDED, USE BACK				

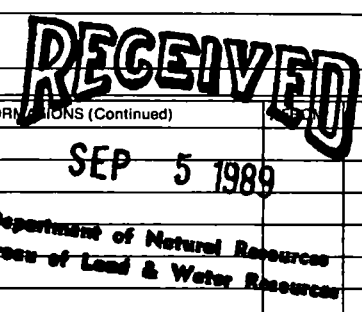

If well telescopes please sketch and show depths.

GROUND LEVEL

		X	

SECTION

15

Please indicate well location X.

ADDITIONAL INFORMATION

RECEIVED  
219  
1 1988

Department of Environment  
and Natural Resources  
1000 ...

If more than one screen, show location of each on sketch.