

# MISSISSIPPI DEPARTMENT OF NATURAL RESOURCES

Bureau of Land and Water Resources

P.O. Box 10631

Jackson, Mississippi 39209

## WATER WELL DRILLERS LOG

COUNTY WELL LOCATED <i>Hancock</i>	
WELL NUMBER <i>R2799</i>	CODED
DATE WELL COMPLETED <i>10-16-89</i>	

PERMIT NUMBER
NAME OF DRILLING FIRM <i>WARD WELL DRG.</i>
<i>Rt. 2, Bx. 350C B.S.L.</i>

NAME & MAILING ADDRESS OF LANDOWNER <i>Shannon m<sup>c</sup> Sullivan</i>			
<i>Rt. 2, Lower Bay Rd.</i>			
<i>Bay St. Louis m<sup>s</sup>.</i>			
WELL LOCATION:	SEC	TOWNSHIP	RANGE
	<i>8</i>	<i>8</i>	<i>14</i>
DISTANCE		DIRECTION	NEAREST TOWN
<i>12</i> Miles		<i>S/W</i>	<i>B.S.L.</i>
OTHER LANDMARK <i>Lower Bay Rd.</i>			
WELL PURPOSE: Home Irrigation, Municipal, Industrial, Fish Pond, etc. <i>Home</i>			

PUMP DATA		
PUMP TYPE (Circle One): Submersible, <input type="checkbox"/> Turbine, <input type="checkbox"/> Jet, <input type="checkbox"/> Flowing Well, Other (Describe) <i>Shallow well jet</i>		
POWER TYPE (Circle One): <input checked="" type="checkbox"/> Electric, <input type="checkbox"/> Tractor, <input type="checkbox"/> Diesel, <input type="checkbox"/> Gasoline, <input type="checkbox"/> Butane, Other (Describe)		
Pump Capacity (GPM) <i>12</i>	No. of Stages <i>1</i>	Setting Depth  <b>FT.</b>
PUMP TEST		
Well yielded _____ GPM with a drawdown of _____ ft. after _____ hours of pumping		

WELL DATA		
Well Depth <i>330'</i>	Casing Diameter (In.) <i>2</i>	Casing Length (Ft.) <i>320</i>
Type of Casing <i>Sh. 40 PVC</i>	Hole Depth <i>330'</i>	Depth to Static Water Level <i>- 13 ft.</i>
TYPE OF COMPLETION: (Circle One or More): Gravel Packed, <input type="checkbox"/> Underreamed, <input type="checkbox"/> Telescoped, Natural Development, <input type="checkbox"/> Open Hole, <input checked="" type="checkbox"/> Other (Describe) <i>Backwash &amp; air</i>		
Top of Lap Pipe or Reduction in Casing  <b>FEET</b> IF TELESCOPED OR MORE THAN ONE SCREEN: USE BACK PAGE		

LOG DATA	
TYPE OF LOG RUN (Circle One): Electric, Gamma Ray, Density, Sonic, <input checked="" type="checkbox"/> No Log Run, Neutron, Other (Describe)	
Name of Organization Running Log	

SCREEN DATA		
Diameter - Inches <i>2</i>	Length - Feet <i>10</i>	Slot Size - Inches <i>.008</i>
Screen Type <i>Sh. 80 PVC</i>	Depth to Bottom - Feet <i>- 330</i>	


GEOLOGIC DATA (Office Use Only)			
Surface Elev.	Geologic Unit	Unit Thickness	Depth to Top
Subs. SWL	Date	Analysis	Aquifer Test
Driller's Remarks <i>N/A</i>			

DESCRIPTION OF FORMATIONS ENCOUNTERED	FROM	TO	FORMATIONS (Continued)	FROM	TO
<i>Clay</i>	<i>0</i>	<i>12</i>	<div style="font-size: 2em; font-weight: bold; border: 2px solid black; padding: 5px; display: inline-block;">RECEIVED</div> <div style="font-size: 1.5em; font-weight: bold; margin-top: 10px;">JAN 26 1990</div> <div style="font-size: 0.8em; margin-top: 10px;">Department of Natural Resources Bureau of Land &amp; Water Resources</div>		
<i>Silt</i>	<i>12</i>	<i>45</i>			
<i>Clay</i>	<i>45</i>	<i>96</i>			
<i>Silt - Red Gravel</i>	<i>96</i>	<i>128</i>			
<i>Clay - Silt</i>	<i>128</i>	<i>210</i>			
<i>Fine Silt</i>	<i>210</i>	<i>235</i>			
<i>Clay - Silt</i>	<i>235</i>	<i>270</i>			
<i>Coarse Silt</i>	<i>270</i>	<i>330</i>			

IF MORE SPACE IS NEEDED, USE BACK

If well telescopes please sketch and show depths.


GROUND LEVEL

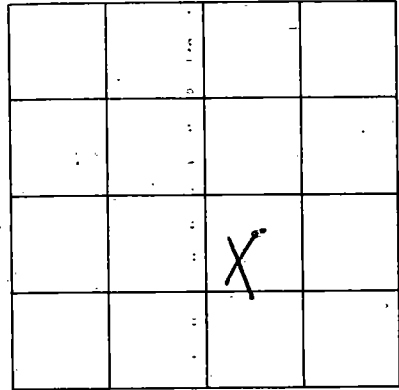

SECTION 8

Please indicate well location X.

ADDITIONAL INFORMATION

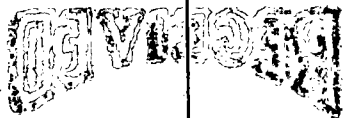

ESTABLISHED UNDER THE PROVISIONS OF  
THE WATER RESOURCES ACT, 1989

If more than one screen,  
show location of each on sketch.