

MISSISSIPPI DEPARTMENT OF NATURAL RESOURCES
Bureau of Land and Water Resources

P.O. Box 10631
Jackson, Mississippi 39209
WATER WELL DRILLERS LOG

| | |
|---|-------|
| COUNTY WELL LOCATED HANCOCK | |
| WELL NUMBER R 2809 | CODED |
| DATE WELL COMPLETED 1-11-1990 | |

| |
|---|
| PERMIT NUMBER |
| NAME OF DRILLING FIRM WARD WELL DRG |
| RJ.2, BY. 3506, BSL. MS. |

| | | | |
|---|------------|---------------------|-------------|
| NAME & MAILING ADDRESS OF LANDOWNER FRANK WILLIAMS | | | |
| SUNFLOWER ST. | | | |
| BAY ST. LOUIS, MS. | | | |
| WELL LOCATION: | SEC | TOWNSHIP | RANGE |
| | 7 | 8 N | 14 E |
| DISTANCE | DIRECTION | NEAREST TOWN | |
| 5 Miles | S/W | of WAUVELAND | |
| OTHER LANDMARK BAY SIDE PARK SUDU. | | | |
| WELL PURPOSE: Home, Irrigation, Municipal, Industrial, Fish Pond, etc. HOME | | | |

| | | |
|---|---------------------------|-------------------------------|
| PUMP DATA | | |
| PUMP TYPE (Circle One): Submersible, Turbine, Jet, Flowing Well, Other (Describe) SHALLOW WELL JET | | |
| POWER TYPE (Circle One): Electric , Tractor, Diesel, Gasoline, Butane, Other (Describe) | | |
| Pump Capacity (GPM) 10 | No. of Stages 1 | Setting Depth - FT. |
| PUMP TEST | | |
| Well yielded _____ GPM with a drawdown of _____ ft. after _____ hours of pumping | | |

| | | |
|---|--|--|
| WELL DATA | | |
| Well Depth 186' | Casing Diameter (In.) 2 | Casing Length (Ft.) 176 |
| Type of Casing SCH. 40 PVC | Hole Depth 186' | Depth to Static Water Level -12' |
| TYPE OF COMPLETION: (Circle One or More): Gravel Packed, Underreamed, Telescoped, Natural Development, Open Hole, Other (Describe) BACKWASH - AIR | | |
| Top of Lap Pipe or Reduction in Casing | | |
| FEET | IF TELESCOPED OR MORE THAN ONE SCREEN: USE BACK PAGE | |

| | |
|--|--|
| LOG DATA | |
| TYPE OF LOG RUN (Circle One): Electric, Gamma Ray, Density, Sonic, No Log Run , Neutron, Other (Describe) | |
| Name of Organization Running Log | |

| | | |
|-----------------------------------|--|-----------------------------------|
| SCREEN DATA | | |
| Diameter - Inches 2" | Length - Feet 10 | Slot Size - Inches .008 |
| Screen Type SCH. 80 PVC | Depth to Bottom - Feet - 186 | |


| | | | |
|--|---------------|----------------|--------------|
| GEOLOGIC DATA (Office Use Only) | | | |
| Surface Elev. | Geologic Unit | Unit Thickness | Depth to Top |
| Subs. SWL | Date | Analysis | Aquifer Test |
| Driller's Remarks N/A | | | |

| DESCRIPTION OF FORMATIONS ENCOUNTERED | FROM | TO |
|---------------------------------------|------------|------------|
| CLAY | 0 | 16 |
| CLAY | 16 | 47 |
| CLAY | 47 | 96 |
| CLAY | 96 | 132 |
| CLAY-SILT | 132 | 160 |
| SILT-PEA GRAVEL | 160 | 186 |
| | | |
| | | |
| | | |
| | | |

| DESCRIPTIONS (Continued) | FROM | TO |
|---|------|----|
| RECEIVED | | |
| APR 13 1990 | | |
| Department of Natural Resources Bureau of Land & Water Resources | | |
| | | |
| | | |
| IF MORE SPACE IS NEEDED, USE BACK | | |

If well telescopes please sketch and show depths.

GROUND LEVEL

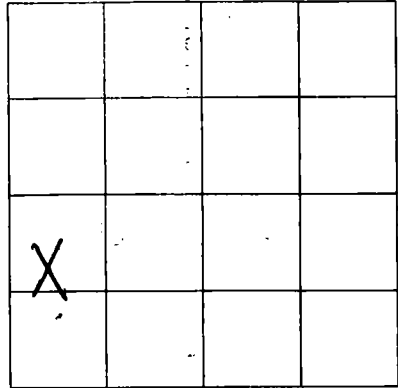

SECTION 7

Please indicate well location X.

ADDITIONAL INFORMATION

If more than one screen,
show location of each on sketch.