

MISSISSIPPI DEPARTMENT OF NATURAL RESOURCES

Bureau of Land and Water Resources

P.O. Box 10631

Jackson, Mississippi 39209

WATER WELL DRILLERS LOG

| | |
|---------------------------------------|-------|
| COUNTY WELL LOCATED <i>Nancock</i> | |
| WELL NUMBER <i>R9835</i> | CODED |
| DATE WELL COMPLETED <i>11-6-90</i> | |

| |
|--|
| PERMIT NUMBER |
| NAME OF DRILLING FIRM <i>Wood Well Drilling</i> |
| <i>6192 Sower Bay Rd. P.O. St.</i> |

| | | | |
|---|------------|-------------------|-------------|
| NAME & MAILING ADDRESS OF LANDOWNER <i>Tommy Mauffrey</i> | | | |
| <i>Sower Bay Rd.</i> | | | |
| <i>Bay St. Louis ms.</i> | | | |
| WELL LOCATION: | SEC | TOWNSHIP | RANGE |
| | <i>24</i> | <i>9 N</i> | <i>15 E</i> |
| DISTANCE | DIRECTION | NEAREST TOWN | |
| <i>2</i> Miles | <i>s/w</i> | of <i>Lumbert</i> | |
| OTHER LANDMARK | | | |
| WELL PURPOSE: Home, Irrigation, Municipal, Industrial, Fish Pond, etc. <i>Home</i> | | | |

| PUMP DATA | | |
|---|---------------------------|---------------------------------|
| PUMP TYPE (Circle One): Submersible, Turbine, Jet, Flowing Well, Other (Describe) <i>Shallow well</i> | | |
| POWER TYPE (Circle One): <input checked="" type="radio"/> Electric, Tractor, Diesel, Gasoline, Butane, Other (Describe) | | |
| Pump Capacity (GPM) <i>10</i> | No. of Stages <i>1</i> | Setting Depth FT. |
| PUMP TEST | | |
| Well yielded _____ GPM with a drawdown of _____ ft. after _____ hours of pumping | | |

| WELL DATA | | |
|---|--|--|
| Well Depth <i>365</i> | Casing Diameter (In.) <i>2</i> | Casing Length (Ft.) <i>355</i> |
| Type of Casing <i>Sh. 40 PVC</i> | Hole Depth <i>365'</i> | Depth to Static Water Level <i>-12'</i> |
| TYPE OF COMPLETION: (Circle One or More): Gravel Packed, Underreamed, Telescoped, Natural Development, Open Hole, Other (Describe) <i>Backwash - air</i> | | |
| Top of Lap Pipe or Reduction in Casing | | |
| FEET | IF TELESCOPED OR MORE THAN ONE SCREEN: USE BACK PAGE | |

| LOG DATA | |
|---|--|
| TYPE OF LOG RUN (Circle One): Electric, Gamma Ray, Density, Sonic, <input checked="" type="radio"/> No Log Run, Neutron, Other (Describe) | |
| Name of Organization Running Log | |

| SCREEN DATA | | |
|----------------------------------|---------------------------------------|------------------------------------|
| Diameter - Inches <i>2</i> | Length - Feet <i>10</i> | Slot Size - Inches <i>1.008</i> |
| Screen Type <i>Sh. 80 PVC</i> | Depth to Bottom - Feet <i>-365</i> | |


| GEOLOGIC DATA (Office Use Only) | | | |
|---------------------------------|---------------|----------------|--------------|
| Surface Elev. | Geologic Unit | Unit Thickness | Depth to Top |
| Subs. SWL | Date | Analysis | Aquifer Test |
| Driller's Remarks <i>N/A</i> | | | |

| DESCRIPTION OF FORMATIONS ENCOUNTERED | FROM | TO | FORMATIONS (Continued) | FROM | TO |
|---------------------------------------|------------|------------|---|------|----|
| <i>Sandy Soil</i> | <i>0</i> | <i>3</i> | RECEIVED <i>JAN 30 1991</i> Dept. of Environmental Quality Bureau of Land & Water Resources | | |
| <i>Clay</i> | <i>3</i> | <i>15</i> | | | |
| <i>Soil</i> | <i>15</i> | <i>48</i> | | | |
| <i>Clay</i> | <i>48</i> | <i>102</i> | | | |
| <i>Soil & Red Gravel</i> | <i>102</i> | <i>120</i> | | | |
| <i>Clay</i> | <i>120</i> | <i>316</i> | | | |
| <i>Coarse Soil</i> | <i>316</i> | <i>365</i> | | | |
| | | | | | |
| | | | | | |
| | | | | | |

IF MORE SPACE IS NEEDED, USE BACK

If well telescopes please sketch and show depths.

GROUND LEVEL

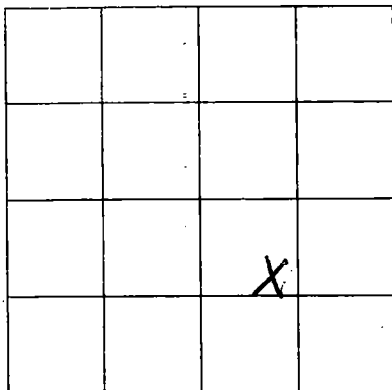

SECTION 22

Please indicate well location X.

ADDITIONAL INFORMATION

If more than one screen,
show location of each on sketch.