

# MISSISSIPPI DEPARTMENT OF NATURAL RESOURCES

Bureau of Land and Water Resources

P.O. Box 10631

Jackson, Mississippi 39209

## WATER WELL DRILLERS LOG

COUNTY, WELL LOCATED <i>Hancock</i>
WELL NUMBER CODED <i>R 2834</i>
DATE WELL COMPLETED <i>10-31-90</i>

PERMIT NUMBER
NAME OF DRILLING FIRM <i>Ward Well Drilling</i>
<i>6192 Lower Bay Rd. D.S.</i>

NAME & MAILING ADDRESS OF LANDOWNER <i>Ray J. Hunter</i> <i>2nd St.</i> <i>Bay St. Louis ms,</i>			
WELL LOCATION: SEC	TOWNSHIP	RANGE	
<i>24</i>	<i>8</i>	<i>N 14 E</i>	
DISTANCE	DIRECTION	NEAREST TOWN	
<i>3</i>	<i>N</i>	<i>Warland</i>	
OTHER LANDMARK <i>Shoreline Park</i>			
WELL PURPOSE: Home, Irrigation, Municipal, Industrial, Fish Pond, etc. <i>Home</i>			

<b>PUMP DATA</b>		
PUMP TYPE (Circle One): Submersible, Turbine, Jet, Flowing Well, Other (Describe) <u><i>owner</i></u>		
POWER TYPE (Circle One): Electric, Tractor, Diesel, Gasoline, Butane, Other (Describe) <u>---</u>		
Pump Capacity (GPM)	No. of Stages	Setting Depth  FT.
PUMP TEST Well yielded _____ GPM with a drawdown of _____ ft. after _____ hours of pumping		

<b>WELL DATA</b>		
Well Depth <i>190'</i>	Casing Diameter (In.) <i>2</i>	Casing Length (Ft.) <i>180'</i>
Type of Casing <i>Sch. 40 PVC</i>	Hole Depth <i>190</i>	Depth to Static Water Level <i>-10'</i>
TYPE OF COMPLETION: (Circle One or More): Gravel Packed, Underreamed, Telescoped, Natural Development, Open Hole, Other (Describe) <u><i>Backwash - an</i></u>		
Top of Lap Pipe or Reduction in Casing		
FEET		IF TELESKOPED OR MORE THAN ONE SCREEN: USE BACK PAGE

<b>LOG DATA</b>	
TYPE OF LOG RUN (Circle One): Electric, Gamma Ray, Density, Sonic, <u><i>No Log Run</i></u> , Neutron, Other (Describe) _____	
Name of Organization Running Log	

<b>SCREEN DATA</b>		
Diameter - Inches <i>2</i>	Length - Feet <i>10</i>	Slot Size - Inches <i>.008</i>
Screen Type <i>Sch. 80 PVC</i>	Depth to Bottom - Feet <i>-190</i>	

<b>GEOLOGIC DATA (Office Use Only)</b>			
Surface Elev.	Geologic Unit	Unit Thickness	Depth to Top
Subs. SWL	Date	Analysis	Aquifer Test

Driller's Remarks <i>Replacement well.</i> <i>old well plugged</i> <i>with spout &amp; capped.</i>
---

DESCRIPTION OF FORMATIONS ENCOUNTERED	FROM	TO	FURTHER INFORMATION FROM	TO
<i>Fill - Clay</i>	<i>0</i>	<i>18</i>	RECEIVED	
<i>Sch.</i>	<i>18</i>	<i>45</i>		
<i>Clay</i>	<i>45</i>	<i>76</i>		
<i>Sch.</i>	<i>76</i>	<i>85</i>		
<i>Clay</i>	<i>85</i>	<i>104</i>		
<i>High Sch.</i>	<i>104</i>	<i>118</i>		
<i>Clay - Silt</i>	<i>118</i>	<i>172</i>		
<i>Sch.</i>	<i>172</i>	<i>190</i>		


JAN 30 1991

Dept. of Environmental Quality  
Bureau of Land & Water Resources

IF MORE SPACE IS NEEDED, USE BACK

If well telescopes please  
sketch and show depths.

GROUND LEVEL

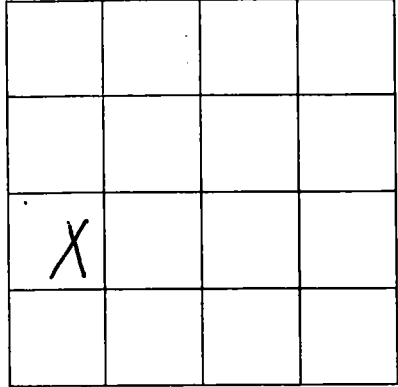

SECTION 28

Please indicate well location X.

ADDITIONAL INFORMATION

Lined area for additional information.

If more than one screen,  
show location of each on sketch.