

MISSISSIPPI DEPARTMENT OF NATURAL RESOURCES

Bureau of Land and Water Resources

P.O. Box 10631
Jackson, Mississippi 39209
WATER WELL DRILLERS LOG

COUNTY WELL LOCATED <i>Hancock</i>	
WELL NUMBER <i>K 2851</i>	CODED
DATE WELL COMPLETED <i>1-22-92</i>	

PERMIT NUMBER
NAME OF DRILLING FIRM <i>Woodwell Dlg.</i>
<i>6192 Lower Bay Rd. B.S.L.</i>

NAME & MAILING ADDRESS OF LANDOWNER <i>Leo Moran</i>		
<i> Hwy 90 W</i>		
<i> Bay St. Louis, Miss.</i>		
WELL LOCATION: SEC	TOWNSHIP	RANGE
<i>1</i>	<i>8 N</i>	<i>14 W</i>
DISTANCE	DIRECTION	NEAREST TOWN
<i>5</i> Miles	<i>W</i>	<i>Waveland</i>
OTHER LANDMARK <i>-</i>		
WELL PURPOSE: Home, Irrigation, Municipal, Industrial, Fish Pond, etc. <i>Home</i>		

PUMP DATA		
PUMP TYPE (Circle One): Submersible, Turbine, Jet, Flowing Well, Other (Describe) <u><i>owner</i></u>		
POWER TYPE (Circle One): Electric, Tractor, Diesel, Gasoline, Butane, Other (Describe) <u><i>H/P</i></u>		
Pump Capacity (GPM)	No. of Stages	Setting Depth FT.
PUMP TEST Well yielded _____ GPM with a drawdown of _____ ft. after _____ hours of pumping		

WELL DATA		
Well Depth <i>273'</i>	Casing Diameter (In.) <i>2</i>	Casing Length (Ft.) <i>263'</i>
Type of Casing <i>Sch. 40 PVC</i>	Hole Depth <i>273'</i>	Depth to Static Water Level <i>- 14'</i>
TYPE OF COMPLETION: (Circle One or More): Gravel Packed, Underreamed, Telescoped, Natural Development, Open Hole, <u><i>Other</i></u> (Describe) <u><i>Backward - air</i></u>		
Top of Lap Pipe or Reduction in Casing FEET <input type="checkbox"/> IF TELESCOPED OR MORE THAN ONE SCREEN: USE BACK PAGE		

LOG DATA	
TYPE OF LOG RUN (Circle One): Electric, Gamma Ray, Density, Sonic, Neutron, Other (Describe) <u><i>No Log Run</i></u>	
Name of Organization Running Log	

SCREEN DATA		
Diameter - Inches <i>2</i>	Length - Feet <i>10</i>	Slot Size - Inches <i>.008</i>
Screen Type <i>Sch. 80 PVC</i>		Depth to Bottom - Feet <i>- 273</i>


GEOLOGIC DATA (Office Use Only)			
Surface Elev.	Geologic Unit	Unit Thickness	Depth to Top
Subs. SWL	Date	Analysis	Aquifer Test
Driller's Remarks <i>N/A</i>			

DESCRIPTION OF FORMATIONS ENCOUNTERED	FROM	TO
<i>clay</i>	<i>0</i>	<i>12</i>
<i>sd.</i>	<i>12</i>	<i>48</i>
<i>clay</i>	<i>48</i>	<i>105</i>
<i>Red Mergel, sd.</i>	<i>105</i>	<i>126</i>
<i>clay - silt</i>	<i>126</i>	<i>248</i>
<i>ml. cone sd.</i>	<i>248</i>	<i>273</i>

FORMATIONS (Continued)	TO
RECEIVED	
MAR 20 1992	
Dept. of Environmental Quality Bureau of Land & Water Resources	
IF MORE SPACE IS NEEDED, USE BACK	

If well telescopes please sketch and show depths.

GROUND LEVEL

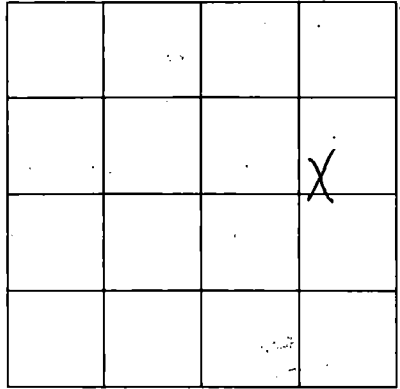

SECTION 1

Please indicate well location X.

ADDITIONAL INFORMATION

Multiple horizontal lines for additional information.

DEVELOPMENT

STATE OF CALIFORNIA
DEPARTMENT OF WATER RESOURCES

If more than one screen, show location of each on sketch.