

**MISSISSIPPI DEPARTMENT OF NATURAL RESOURCES**  
Bureau of Land and Water Resources

P.O. Box 10631  
Jackson, Mississippi 39209  
**WATER WELL DRILLERS LOG**

|   |       |   |
|---|-------|---|
| COUNTY WELL LOCATED<br><i>Warren</i>    |       | PERMIT NUMBER                                 |
| WELL NUMBER<br><i>R2856</i>             | CODED |   |
| DATE WELL COMPLETED<br><i>5-11-1992</i> |       | NAME OF DRILLING FIRM<br><i>Ward Well Dr.</i> |
| 6192 Lower Bay Rd, B.S.S.               |       |   |

|   |                         |                                  |                                |
|---|-------------------------|----------------------------------|--------------------------------|
| NAME & MAILING ADDRESS OF LANDOWNER<br><i>Lawrence Bernois</i><br><i>Clermont Harbor Blvd</i><br><i>Clermont Harbor, ms</i> |                         |                                  |                                |
| WELL LOCATION:  | SEC<br><i>8</i>         | TOWNSHIP<br><i>9<sup>N</sup></i> | RANGE<br><i>14<sup>E</sup></i> |
| DISTANCE<br><i>3</i>  | DIRECTION<br><i>S/W</i> | NEAREST TOWN<br><i>Warroad</i>   |                                |
| OTHER LANDMARK  |                         |                                  |                                |
| WELL PURPOSE: Home, Irrigation, Municipal, Industrial, Fish Pond, etc.<br><i>Home</i>                                       |                         |                                  |                                |

|  |                           |                                 |
|--|---------------------------|---------------------------------|
| PUMP DATA  |                           |                                 |
| PUMP TYPE (Circle One):<br>Submersible, Turbine, <b>Jet</b> Flowing Well, Other (Describe) _____ |                           |                                 |
| POWER TYPE (Circle One):<br>Electric, Tractor, Diesel, Gasoline, Butane, Other (Describe) _____  |                           |                                 |
| Pump Capacity (GPM)<br><i>12</i>   | No. of Stages<br><i>1</i> | Setting Depth<br><br><b>FT.</b> |
| PUMP TEST  |                           |                                 |
| Well yielded _____ GPM with a drawdown of _____ ft. after _____ hours of pumping                 |                           |                                 |

|   |  |  |
|---|--|--|
| WELL DATA   |  |  |
| Well Depth<br><i>341'</i>   | Casing Diameter (In.)<br><i>2</i>                    | Casing Length (Ft.)<br><i>331'</i>         |
| Type of Casing<br><i>Sch. 40 PVC</i>  | Hole Depth<br><i>341'</i>                            | Depth to Static Water Level<br><i>-12'</i> |
| TYPE OF COMPLETION: (Circle One or More):<br>Gravel Packed, Underreamed, Telescoped, Natural Development, Open Hole, Other (Describe) <i>Backwash - air</i> |  |  |
| Top of Lap Pipe or Reduction in Casing  |  |  |
| FEET  | IF TELESCOPED OR MORE THAN ONE SCREEN: USE BACK PAGE |  |

|   |  |
|---|--|
| LOG DATA  |  |
| TYPE OF LOG RUN (Circle One):<br>Electric, Gamma Ray, Density, Sonic, <b>No Log Run</b> , Neutron, Other (Describe) _____ |  |
| Name of Organization Running Log  |  |

|                                   |                                       |                                   |
|-----------------------------------|---------------------------------------|-----------------------------------|
| SCREEN DATA                       |                                       |                                   |
| Diameter - Inches<br><i>2</i>     | Length - Feet<br><i>10'</i>           | Slot Size - Inches<br><i>1008</i> |
| Screen Type<br><i>Sch. 80 PVC</i> | Depth to Bottom - Feet<br><i>341'</i> |                                   |

|                                 |               |                |              |
|---------------------------------|---------------|----------------|--------------|
| GEOLOGIC DATA (Office Use Only) |               |                |              |
| Surface Elev.                   | Geologic Unit | Unit Thickness | Depth to Top |
| Subs. SWL                       | Date          | Analysis       | Aquifer Test |
| Driller's Remarks               |               |                |              |

| DESCRIPTION OF FORMATIONS ENCOUNTERED | FROM       | TO         |
|---------------------------------------|------------|------------|
| <i>Clay</i>                           | <i>0</i>   | <i>8</i>   |
| <i>S.S.</i>                           | <i>8</i>   | <i>37</i>  |
| <i>Clay</i>                           | <i>37</i>  | <i>65</i>  |
| <i>Clay - Shell</i>                   | <i>65</i>  | <i>80</i>  |
| <i>Clay</i>                           | <i>80</i>  | <i>110</i> |
| <i>Red Gravel - S.S.</i>              | <i>110</i> | <i>130</i> |
| <i>Clay - Silt</i>                    | <i>130</i> | <i>222</i> |
| <i>Fine S.S.</i>                      | <i>222</i> | <i>240</i> |
| <i>Clay - Silt</i>                    | <i>240</i> | <i>315</i> |
| <i>Coarse S.S.</i>                    | <i>315</i> | <i>341</i> |

|  |    |
|--|----|
| <b>RECEIVED</b>  |    |
| <b>JUL 17 1992</b>   |    |
| Dept. of Environmental Quality<br>Bureau of Land & Water Resources |    |
| FORMATIONS ENCOUNTERED FROM  | TO |
| IF MORE SPACE IS NEEDED, USE BACK                                  |    |

If well telescopes please sketch and show depths.


GROUND LEVEL

|  |  |   |  |
|--|--|---|--|
|  |  |   |  |
|  |  |   |  |
|  |  | X |  |
|  |  |   |  |

SECTION 8

Please indicate well location X.

ADDITIONAL INFORMATION

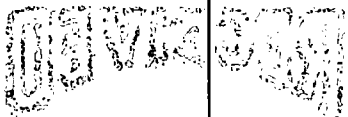

If more than one screen, show location of each on sketch.

If more than one screen, show location of each on sketch.