

MISSISSIPPI DEPARTMENT OF NATURAL RESOURCES

Bureau of Land and Water Resources

Southport Mall

P.O. Box 10631

Jackson, Mississippi 39209

WATER WELL DRILLERS LOG

Hancock
K 2860

8-17-92 Bud Penton Water Well Hancock
date well completed firm name county well located

LANDOWNER: H.W. Spiers
100 Idaho St. Waveland
Ms.
(mailing address)

description of formations encountered	from	to
GRAY shale	0	18
White Sand	18	65
blue shale	65	305
Gray Sand	305	338

WELL LOCATION:
sec. 27 T. 8 N. R. 14 E
S W
2 miles West of Bay St Louis
(distance) (direction) (nearest town)

WELL PURPOSE: Home
(home, irrigation, municipal, industrial)

- WELL COMPLETION DATA:
- (1) diameter (inches) 5
 - (2) total depth (feet) 338
 - (3) static water level (feet) 0 below above top of ground.
 - (4) casing PVC, 328 ;
(material) (depth)
2"
(size) If telescope see back.
 - (5) screen 10', 328 338
(length) (depth to top)
2", PVC
(size) (material)
 - (6) pump 1/2, 11
(HP) (yield gpm)
electric
(type power)
 - (7) electric log NO
(yes or no)

(organization running log)
 - (8) how well bottom plugged sands hawk

RECEIVED


SEP 18 1992

Dept. of Environmental Quality
Bureau of Land & Water Resources

DRILLERS REMARKS:

If well telescopes please sketch and show depths.

GROUND LEVEL

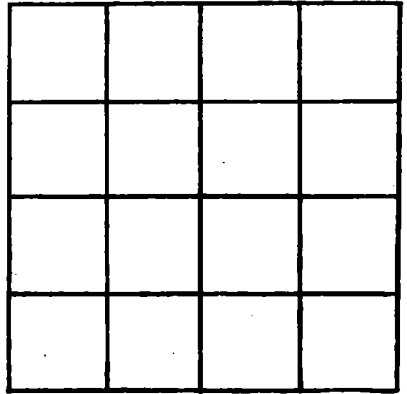

SECTION _____

Please indicate well location X.

ADDITIONAL INFORMATION

If more than one screen,
show locations of each on sketch.