

MISSISSIPPI DEPARTMENT OF NATURAL RESOURCES

Bureau of Land and Water Resources

P.O. Box 10631
Jackson, Mississippi 39209
WATER WELL DRILLERS LOG

COUNTY WELL LOCATED <i>Hancock</i>	
WELL NUMBER <i>K 7870</i>	CODED
DATE WELL COMPLETED <i>Sept 4, 1992</i>	

PERMIT NUMBER
NAME OF DRILLING FIRM <i>Ward Well Drg.</i>
<i>6192 Town Bay St. Rd. S.</i>

NAME & MAILING ADDRESS OF LANDOWNER <i>Gary Bender</i>		
<i>Larson Drive</i>		
<i>Bay St. Louis ms.</i>		
WELL LOCATION: SEC	TOWNSHIP	RANGE
<i>22</i>	<i>8</i> ^N / _S	<i>14</i> ^E / _W
DISTANCE	DIRECTION	NEAREST TOWN
<i>2</i> Miles	<i>N/W</i>	<i>of B.S.S.</i>
OTHER LANDMARK <i>Garden Dale Sude.</i>		
WELL PURPOSE: Home, Irrigation, Municipal, Industrial, Fish Pond, etc. <i>Home</i>		

PUMP DATA		
PUMP TYPE (Circle One): Submersible, Turbine, Jet, Flowing Well, Other (Describe) <u><i>currier</i></u>		
POWER TYPE (Circle One): Electric, Tractor, Diesel, Gasoline, Butane, Other (Describe) _____ H/P _____		
Pump Capacity (GPM)	No. of Stages	Setting Depth
		FT.
PUMP TEST		
Well yielded _____ GPM with a drawdown of _____ ft. after _____ hours of pumping		

WELL DATA		
Well Depth <i>548'</i>	Casing Diameter (In.) <i>2</i>	Casing Length (Ft.) <i>528'</i>
Type of Casing <i>Sch. 40 PVC</i>	Hole Depth <i>548'</i>	Depth to Static Water Level <i>+5'</i> ✓
TYPE OF COMPLETION: (Circle One or More): Gravel Packed, Underreamed, Telescoped, Natural Development, Open Hole, <u><i>Other</i></u> (Describe) <u><i>backwash - air</i></u>		
Top of Lap Pipe or Reduction in Casing		
FEET	IF TELESCOPED OR MORE THAN ONE SCREEN: USE BACK PAGE	

LOG DATA	
TYPE OF LOG RUN (Circle One): Electric, Gamma Ray, Density, Sonic, Neutron, Other (Describe) _____ <u><i>No Log Run.</i></u>	
Name of Organization Running Log	

SCREEN DATA		
Diameter - Inches <i>2</i>	Length - Feet <i>20</i>	Slot Size - Inches <i>.008</i>
Screen Type <i>Sch. 80 PVC</i>	Depth to Bottom - Feet <i>-548'</i>	


GEOLOGIC DATA (Office Use Only)			
Surface Elev.	Geologic Unit	Unit Thickness	Depth to Top
Subs. SWL	Date	Analysis	Aquifer Test
Driller's Remarks <i>N/A</i>			

DESCRIPTION OF FORMATIONS ENCOUNTERED	FROM	TO
<i>Fill</i>	<i>0</i>	<i>2</i>
<i>Clay</i>	<i>2</i>	<i>15</i>
<i>Silt</i>	<i>15</i>	<i>48</i>
<i>Clay - Silt</i>	<i>48</i>	<i>94</i>
<i>Fine Silt</i>	<i>94</i>	<i>115</i>
<i>Clay - Silt</i>	<i>115</i>	<i>156</i>
<i>Fine Silt</i>	<i>156</i>	<i>174</i>
<i>Clay - Silt</i>	<i>174</i>	<i>365</i>
<i>Coarse Silt</i>	<i>365</i>	<i>420</i>
<i>Clay Silt</i>	<i>420</i>	<i>490</i>
<i>Coarse Silt</i>	<i>490</i>	<i>548</i>

FORMATIONS (Continued)	FROM	TO
<div style="font-size: 2em; font-weight: bold; opacity: 0.5; transform: rotate(-5deg); display: inline-block;">RECEIVED</div> <div style="font-size: 1.5em; font-weight: bold; display: inline-block;">DEC 04 1992</div> <div style="font-size: 1.2em; font-weight: bold; display: inline-block;">Dept. of Environmental Quality Bureau of Land & Water Resources</div>		
IF MORE SPACE IS NEEDED, USE BACK		

If well telescopes please sketch and show depths.

GROUND LEVEL

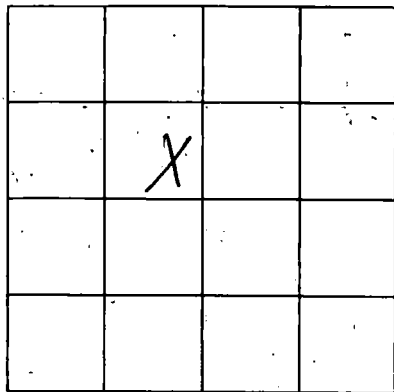

SECTION 22

Please indicate well location X.

ADDITIONAL INFORMATION

RECEIVED

If more than one screen,
show location of each on sketch.