

MISSISSIPPI DEPARTMENT OF ENVIRONMENTAL QUALITY

Office of Land and Water Resources

P. O. Box 10631
Jackson, MS 39289-0631

WATER WELL DRILLERS LOG

COUNTY WELL LOCATED Hancock	
WELL NUMBER K 2905	CODED
DATE WELL COMPLETED 4-28-95	

PERMIT NUMBER 0-239
NAME OF DRILLING FIRM McGill

NAME & MAILING ADDRESS OF LANDOWNER Charles Scherer			
Central Ave			
Bay St. Louis			
WELL LOCATION	SEC	TOWNSHIP	RANGE
	28	8	N 14 E
DISTANCE	DIRECTION	NEAREST TOWN	
4 Miles	North of	B.S.L.	
OTHER LANDMARK			
WELL PURPOSE: <input checked="" type="radio"/> Home Irrigation, <input type="radio"/> Municipal, <input type="radio"/> Industrial, <input type="radio"/> Fish Pond, etc.			

PUMP DATA		
PUMP TYPE (Circle One): Submersible, Turbine, <input checked="" type="radio"/> Jet, Flowing Well, Other (Describe) _____		
POWER TYPE (Circle One): Electric, Tractor, Diesel, Gasoline, Butane, Other (Describe) _____ H/P _____		
Pump Capacity (GPM)	No. of Stages	Setting Depth
N/A		FT.
PUMP TEST		
Well yielded _____ GPM with a drawdown of _____ ft. after _____ hours of pumping		

WELL DATA		
Well Depth 720	Casing Diameter (In.) 2	Casing Length (Ft.) 700
Type of Casing PUC	Hole Depth 720	Depth to Static Water Level Flow
TYPE OF COMPLETION: (Circle One or More): <input checked="" type="radio"/> Gravel Packed, <input type="radio"/> Underreamed, <input type="radio"/> Telescoped, <input type="radio"/> Natural Development, <input type="radio"/> Open Hole, <input type="radio"/> Other (Describe) _____		

LOG DATA	
TYPE OF LOG RUN (Circle One): <input checked="" type="radio"/> No Log Run, <input type="radio"/> Electric, <input type="radio"/> Gamma Ray, <input type="radio"/> Density, <input type="radio"/> Sonic, <input type="radio"/> Neutron, Other (Describe) _____	
Name of Organization Running Log	

WELL GROUTED TO A DEPTH OF 10 FEET Type Grout (circle one): Cement, Bentonite, or Mix

GEOLOGIC DATA (Office Use Only)			
Surface Elev.	Geologic Unit	Unit Thickness	Depth to Top
Subs. SWL	Date	Analysis	Aquifer Test
Driller's Remarks			
Top of Lap Pipe or Reduction in Casing			
FEET		IF TELESCOPED OR MORE THAN ONE SCREEN: USE BACK PAGE	

SCREEN DATA		
Diameter - Inches 2	Length - Feet 20	Slot Size - Inches 0006
Screen Type puc	Depth to Bottom - Feet 720	

DESCRIPTION OF FORMATIONS ENCOUNTERED	FROM	TO
mud	0	120
sand	120	140
mud	140	360
sand	360	370
mud	370	490
sand	490	500
mud	500	640
sand	640	730


FORMATIONS (Continued)	FROM	TO
RECEIVED		
MAR 17 1997		
Dept. of Environmental Quality Office of Land & Water Resources		
IF MORE SPACE IS NEEDED, USE BACK		

If well telescopes please sketch and show depths.

PH-0
12/1/41

12/1/41
70-53-11

GROUND LEVEL

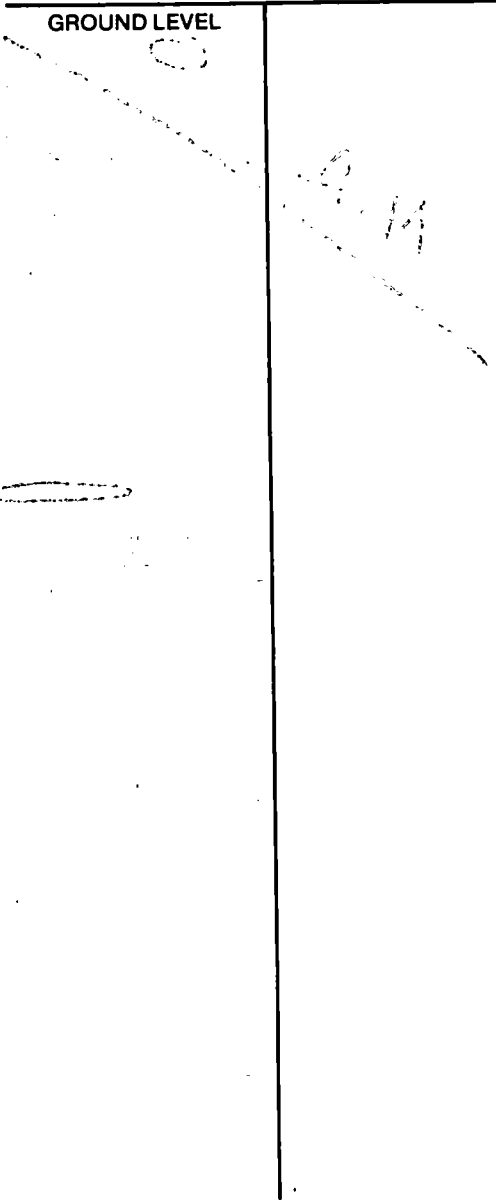

1	2	3	4

SECTION _____

Please indicate well location X.

ADDITIONAL INFORMATION

Handwritten notes and lines in the 'ADDITIONAL INFORMATION' section, including some illegible scribbles and lines.

If more than one screen, show location of each on sketch.