

K ~~260~~ 2919

K

WATER WELL DRILLERS LOG

4-15-64

Date: 4-15, 1964, Driller: Letter Well Works County Hancock

(Name)

(1) Owner of Land: Mrs. Willie M. Williams  
 (Name)  
Rt 1 - Bay St. Louis, Miss.  
 (Address)

Description & Color of Materials Sand, Clay, Red Clay, Shell, etc.	Thick- ness Feet	Depth Feet
<u>sand</u>	<u>15</u>	<u>15</u>
<u>clay</u>	<u>118</u>	<u>133</u>
<u>sand</u>	<u>17</u>	<u>150</u>

(2) Location: NE 1/4, SW 1/4, Sec. 46 T8S R14E  
1 miles NW, of Bay St. Louis  
 (distance) (direction) (Nearest Town)

(3) Topography: flat  
 (Hilly) (Flat) (Level)

(4) Purpose of Well: domestic Home  
 (Domestic Irrigation  
 Municipal, Industrial, Other)


Information upon completion of well:

- (1) Diameter 2 inches.
- (2) Total Depth 150 feet.
- (3) Water Level 3 feet below top of ground.
- (4) Cased to app, Size 2"
- (5) Screen: Size 2", Length 5'
- (6) Were any formations sealed against pollution?  
no yes,  no.

If YES depth of formation \_\_\_\_\_

Why \_\_\_\_\_

Drillers Remarks: \_\_\_\_\_

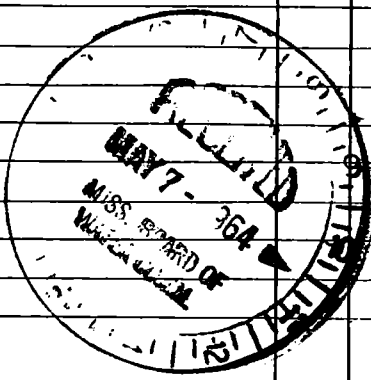

(Use Back Side)

Well No.

MISSISSIPPI BOARD

MISSISSIPPI BOARD