


K 2922  
7-21-61

K 304

WATER WELL DRILLERS LOG

Date: 7-21, 1961, Driller: Sutter Well Works County Hancock  
(Name)

		Description & Color of Materials Sand, Clay, Red Clay, Shell, etc.	Thick- ness Feet	Depth Feet
(1) Owner of Land: Fred Strahan (Name)		Clay	106	106
Box 298- Larose, La. (Address)		Sand	51	157
(2) Location: 1/4, 1/4, Sec. 17 T9 R6, Bay St. 5 miles NW of Idonia (distance) (direction) (Nearest Town)				
(3) Topography: flat (Hilly) (Flat) (Level)				
(4) Purpose of Well: domestic (Domestic Irrigation Municipal, Industrial, Other)				

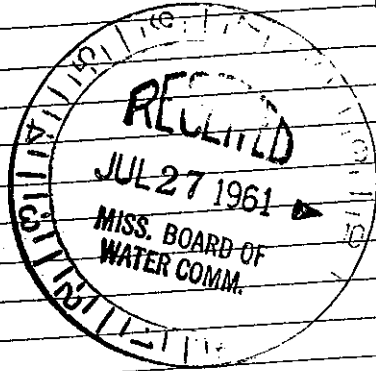

Information upon completion of well:

- (1) Diameter 2 inches.
- (2) Total Depth 157 feet.
- (3) Water Level 2 feet above below top of ground.
- (4) Cased to all, Size 2"
- (5) Screen: Size 2", Length 5"
- (6) Were any formations sealed against pollution?  
yes,  no.

If YES depth of formation \_\_\_\_\_

Why \_\_\_\_\_

Drillers Remarks: \_\_\_\_\_

Well No.

(Use Back Side)