

K 2927

WATER WELL DRILLERS LOG

9-25-61

Date: 9-25, 1961, Driller: Sutter Well Works County Hancock

K 2305  
314

(1) Owner of Land: A L Murocher  
(Name)  
3205 Lafitte St. - N.O. La.  
(Address) SUB DIV

(2) Location: 1/4, 1/4, Sec. T R  
5 miles NW of Bay St Louis  
(distance) (direction) (Nearest Town)

(3) Topography: flat  
(Hilly) (Flat) (Level)


(4) Purpose of Well: domestic  
(Domestic Irrigation, Municipal, Industrial, Other)

Description & Color of Materials Sand, Clay, Red Clay, Shell, etc.	Thick- ness Feet	Depth Feet
Clay	80	80
Sand + gravel	58	138
Mixed Clay-sand	335	473
Sand	36	509

Information upon completion of well:

- (1) Diameter 1 1/4 inches.
- (2) Total Depth 509 feet.
- (3) Water Level 3" above feet below top of ground.
- (4) Cased to all, Size 1 1/4" (Top 116' of 1 1/2")
- (5) Screen: Size 1/4", Length 5'
- (6) Were any formations sealed against pollution?  
yes,  no.

If YES depth of formation \_\_\_\_\_  
Why \_\_\_\_\_  
Drillers Remarks: \_\_\_\_\_

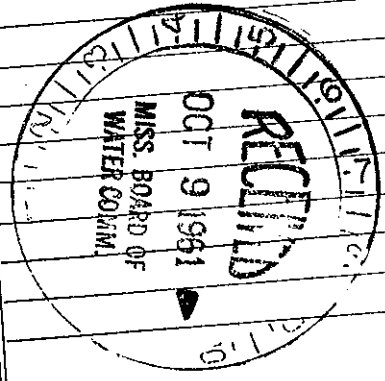

Well