

HANCOCK MISSISSIPPI BOARD OF WATER COMMISSIONERS

K ~~2928~~
10-23-61


WATER WELL DRILLERS LOG

K-306

Date: 10-23, 1961, Driller: Sutter Well Works county Hancock

(Name)

	Description & Color of Materials Sand, Clay, Red Clay, Shell, etc.	Thick- ness Feet	Depth Feet
(1) Owner of Land: <u>Peter Gracianette</u> (Name)	Clay	10	10
<u>831 alix - Algiers, La.</u> (Address)	sand	50	60
(2) Location: <u>SW 1/4, NW 1/4, Sec. 47 T85R14W</u>	Clay	95	155
<u>2</u> miles <u>NW</u> of <u>Bay St Louis</u> (distance) (direction) (Nearest Town)	sand	23	178
(3) Topography: <u>flat</u> (Hilly) (Flat) (Level)			
(4) Purpose of Well: <u>domestic</u> (Domestic Irrigation Municipal, Industrial, Other)			
Information upon completion of well:			
(1) Diameter <u>2</u> inches.			
(2) Total Depth <u>178</u> feet.			
(3) Water Level <u>flow</u> feet below top of ground.			
(4) Cased to <u>all</u> , Size <u>2"</u>			
(5) Screen: Size <u>2"</u> , Length <u>5'</u>			
(6) Were any formations sealed against pollution? <u>yes</u> , <input checked="" type="checkbox"/> no.			
If YES depth of formation _____			
Why _____			
Drillers Remarks: _____			

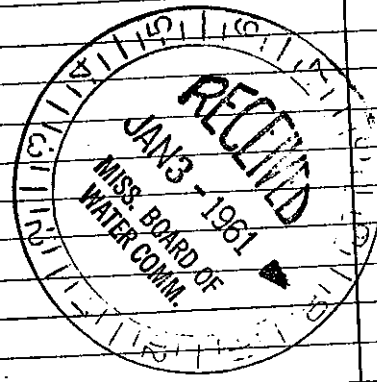

Well No.

(Use Back Side)