

MISSISSIPPI DEPARTMENT OF ENVIRONMENTAL QUALITY

Office of Land and Water Resources

P. O. Box 10631
Jackson, MS 39289-0631

WATER WELL DRILLERS LOG

COUNTY WELL LOCATED HARRIS	
WELL NUMBER K-2949	CODED
DATE WELL COMPLETED 9-7-01	

PERMIT NUMBER
NAME OF DRILLING FIRM M+M WELL SER.

NAME & MAILING ADDRESS OF LANDOWNER BRIAN BUSBY
10052 NEW MEXICO
Bay St. Louis 39520
Latitude:
Longitude:
WELL LOCATION: SEC 28 TOWNSHIP 8 N RANGE 14 E
DISTANCE _____ MILES _____ OF _____ NEAREST TOWN
OTHER LANDMARK
WELL PURPOSE: Home, Irrigation, Municipal, Industrial, Fish Pond, etc.

PUMP DATA

PUMP TYPE (Circle One):
Submersible, Turbine, Jet, Flowing Well,
Other (Describe) SHALLOW WELL

POWER TYPE (Circle One):
Electric, Tractor, Diesel, Gasoline, Butane,
Other (Describe) _____ H/P 1/2

DESCRIPTION OF FORMATIONS ENCOUNTERED	FROM	TO
TOP SOIL	0	3
CLAY (BROWN)	3	15
SAND	15	37
SANDY CLAY	50	137
SAND	137	160

WELL DATA

Well Depth 160	Casing Diameter (In.) 2	Casing Length (Ft.) 150
Type of Casing PVC	Hole Depth 160	Depth to Static Water Level 8

TYPE OF COMPLETION: (Circle One or More):
Gravel Packed, Underreamed, Telescoped,
Natural Development, Open Hole, Other
(Describe) _____

WELL GROUTED TO A DEPTH OF **10** FEET
Type Grout (circle one) Cement, Bentonite, or Mix

SCREEN DATA

Diameter - Inches 2	Length - Feet 10	Slot Size - Inches 1006
Screen Type PVC	Depth to Bottom - Feet 150-160	

REC'D SEP 27 2001

Top of Lap Pipe or Reduction in Casing

FEET IF TELESCOPED OR MORE THAN ONE SCREEN: USE BACK PAGE

I certify that the well was drilled, constructed and completed in accordance with all applicable Requirements of the Mississippi Department of Environmental Quality and/or the Mississippi Department of Health regulations and state laws.


Alvin Maddox 0563
Signature of Licensed Driller and License No.

9-24-01
Date

Additional Information Required On Back

If well telescopes please sketch and show depths.

GROUND LEVEL

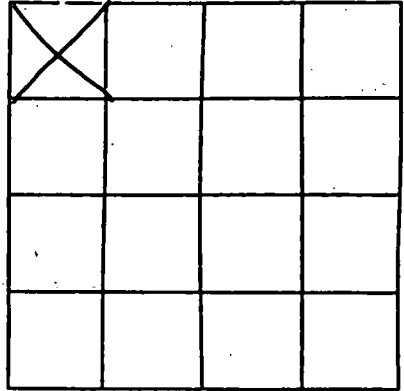

SECTION _____

Please indicate well location X.

Pump Capacity (GPM)	No. of Stages	Setting Depth	FT.
---------------------	---------------	---------------	-----

PUMP TEST

Well yielded _____ GPM with
 a drawdown of _____ ft.
 after _____ hours of pumping

LOG DATA

TYPE OF LOG RUN (Circle One): No Log Run, Electric, Gamma Ray, Density, Sonic, Neutron, Other (Describe) _____

Name of Organization Running Log _____

GEOLOGIC DATA (Office Use Only)

Surface Elev.	Geologic Unit	Unit Thickness	Depth to Top
Subs. SWL	Date	Analysis	Aquifer Test

Driller's Remarks

If more than one screen, show location of each on sketch.