

House #2

MISSISSIPPI DEPARTMENT OF ENVIRONMENTAL QUALITY

Office of Land and Water Resources

P. O. Box 10631

Jackson, MS 39289-0631

WATER WELL DRILLERS LOG

COUNTY WELL LOCATED HEARN COCK	
WELL NUMBER # 200	CODED
K-2976	
DATE WELL COMPLETED 3/10/02	

PERMIT NUMBER 0519
NAME OF DRILLING FIRM BURGEWELL SERVICE

NAME & MAILING ADDRESS OF LANDOWNER CLAY STOCK STILL			
FOR SALE!			
BUILDER'S PICKUP NEMS			
Latitude:			
Longitude: RD. 536 TO 16TH ST			
WELL LOCATION	SEC	TOWNSHIP	RANGE
	28	8	N 14 E
DISTANCE	DIRECTION	NEAREST TOWN	
0 Miles		of BAYST. LOUIS	
OTHER LANDMARK 16TH STREET			
WELL PURPOSE (Circle one) Irrigation, Municipal, Industrial, Fish Pond, etc.			

PUMP DATA	
PUMP TYPE (Circle One):	Flowing Well,
Submersible, Turbine, (Jet)	
Other (Describe)	
POWER TYPE (Circle One):	
(Electric) Tractor, Diesel, Gasoline, Butane,	
Other (Describe) _____ H/P _____	

DESCRIPTION OF FORMATIONS ENCOUNTERED	FROM	TO
BLACK DIRT	0	25
BLUE CLAY	25	30
SAND	30	60
WHITE CLAY	60	85
BLUE CLAY	85	160
FINE SAND	160	180
BLUE CLAY	180	220
FINE SAND	220	240
COARSE SAND	240	290
ROCK SAND	290	390

WELL DATA

Well Depth 390	Casing Diameter (In.) 2"	Casing Length (Ft.) 390
Type of Casing PVC	Hole Depth 390	Depth to Static Water Level 5'
TYPE OF COMPLETION: (Circle One or More): Gravel Packed, Underreamed, Telescoped, Natural Development, Open Hole, Other (Describe) AIR		

WELL GROUTED TO A DEPTH OF **10 FEET**
Type Grout (circle one): Cement, Bentonite, or **Mix**

SCREEN DATA

Diameter - Inches 2	Length - Feet 20'	Slot Size - Inches #10
Screen Type SLOT	Depth to Bottom - Feet 390	

Top of Lap Pipe or Reduction in Casing

FEET	IF TELESCOPED OR MORE THAN ONE SCREEN: USE BACK PAGE
------	--

RECEIVED
JUL 25 2002
BY: OLWR

I certify that the well was drilled, constructed and completed in accordance with all applicable Requirements of the Mississippi Department of Environmental Quality and/or the Mississippi Department of Health regulations and state laws.


Josh P. Bury
Signature of Licensed Driller and License No.

7/17/02
Date

If well telescopes please sketch and show depths.

GROUND LEVEL

TURN LEFT OFF Hwy 53
TO RD # 536 go DOWN TO
16TH HOUSE ON RIGHT
WELL IN REAR

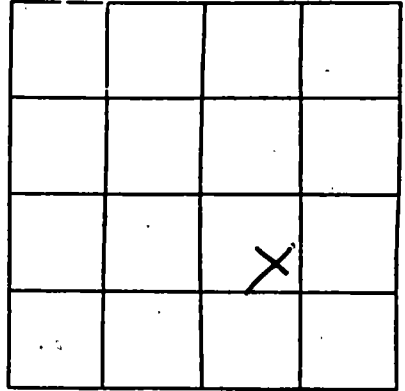

SECTION 28

Please indicate well location X.

Pump Capacity (GPM)	No. of Stages	Setting Depth	FT.
---------------------	---------------	---------------	-----

PUMP TEST

Well yielded _____ GPM with
a drawdown of _____ ft.
after _____ hours of pumping

LOG DATA

TYPE OF LOG RUN (Circle One): No Log Run, Electric, Gamma Ray, Density, Sonic, Neutron, Other (Describe) _____

Name of Organization Running Log

GEOLOGIC DATA (Office Use Only)

Surface Elev.	Geologic Unit	Unit Thickness	Depth to Top
Subs. SWL	Date	Analysis	Aquifer Test

Driller's Remarks

If more than one screen, show location of each on sketch.