

House #1

MISSISSIPPI DEPARTMENT OF ENVIRONMENTAL QUALITY
Office of Land and Water Resources

P. O. Box 10631
Jackson, MS 39289-0631
WATER WELL DRILLERS LOG

COUNTY WELL LOCATED
HANCOCK

WELL NUMBER
#35

CODED

K-2977

DATE WELL COMPLETED
6/24/02

PERMIT NUMBER
0519

NAME OF DRILLING FIRM
BURGEWELL SERVICE

NAME & MAILING ADDRESS OF LANDOWNER
CLAY STOCK STILL

BURDER P. CAYUENA MS,

Latitude:
Longitude: **2**

WELL LOCATION: SEC **28** TOWNSHIP **8** RANGE **14** **N** **S** **E**

DISTANCE **0** Miles DIRECTION _____ NEAREST TOWN **of BAY ST. LOUIS**

OTHER LANDMARK
515TH STREET RD 33670

WELL PURPOSE: Home, Irrigation, Municipal, Industrial, Fish Pond, etc.

PUMP DATA

PUMP TYPE (Circle One):
Submersible, Turbine, **J81** Flowing Well,
Other (Describe) _____

POWER TYPE (Circle One):
 Electric, Tractor, Diesel, Gasoline, Butane,
Other (Describe) _____ H/P _____

DESCRIPTION OF FORMATIONS ENCOUNTERED	FROM	TO
BLACK DIRT	0	25
BLUE CLAY	25	30
SAND	30	60
WHITE CLAY	60	85
BLUE CLAY	85	160
FINE SAND	160	180
BLUE CLAY	180	220
FINE SAND	220	240
COARSE SAND	240	260

WELL DATA

Well Depth 290	Casing Diameter (In.) 2"	Casing Length (Ft.) 290
Type of Casing PVC	Hole Depth 290	Depth to Static Water Level 10'

TYPE OF COMPLETION: (Circle One or More):
Gravel Packed, Underreamed, Telescoped,
Natural Development, Open Hole, Other
(Describe) **AIR**

WELL GROUTED TO A DEPTH OF **10 FEET**
Type Grout (circle one): Cement, Bentonite, or **MIX**

SCREEN DATA

Diameter - Inches 2	Length - Feet 20'	Slot Size - Inches #10
Screen Type SCOT		Depth to Bottom - Feet 290

RECEIVED

JUL 25 2002

BY: OLWR

Top of Lap Pipe or Reduction in Casing
FEET IF TELESCOPED OR MORE THAN ONE SCREEN: USE BACK PAGE

I certify that the well was drilled, constructed and completed in accordance with all applicable Requirements of the Mississippi Department of Environmental Quality and/or the Mississippi Department of Health regulations and state laws.

John R. By
Signature of Licensed Driller and License No.


7/17/02
Date

Additional Information Required On Back

If well telescopes please sketch and show depths.

TURN TO LEFT OFF Hwy 53
RD. #536 go DOWN TO
15TH STREET TO RIGHT
2ND BLOCK 2 HOUSES
THIS IS 1ST ONE

GROUND LEVEL

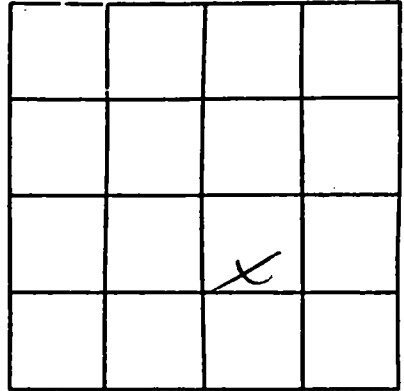

SECTION 28

Please indicate well location X.

Pump Capacity (GPM)	No. of Stages	Setting Depth	FT.
---------------------	---------------	---------------	-----

PUMP TEST

Well yielded _____ GPM with
a drawdown of _____ ft.
after _____ hours of pumping

LOG DATA

TYPE OF LOG RUN (Circle One): No Log Run,
Electric, Gamma Ray, Density, Sonic, Neutron,
Other (Describe) _____

Name of Organization Running Log

GEOLOGIC DATA (Office Use Only)

Surface Elev.	Geologic Unit	Unit Thickness	Depth to Top
Subs. SWL	Date	Analysis	Aquifer Test

Driller's Remarks

If more than one screen,
show location of each on sketch.