

K2985

10-30-61

WATER WELL DRILLERS LOG

K

Date: 10-30, 1961, Driller: Sutter Well Works County Hancock

(Name)

(1) Owner of Land: Mary G. Robertson

(Name)

Clermont Harbor, Miss.

(Address)

(2) Location: 1/4, 1/4, Sec. 3 T9R14W

CLERMONT HARBOR

of Louisiana

miles (distance)

(direction)

(Nearest Town)

(3) Topography: flat

(Hilly)

(Flat)

(Level)

(4) Purpose of Well: domestic Home

(Domestic Irrigation, Municipal, Industrial, Other)

Information upon completion of well:

(1) Diameter 2 inches.

(2) Total Depth 289 feet.

(3) Water Level 3 feet below top of ground.

284

(4) Cased to top, Size 2"

(5) Screen: Size 2", Length 5'

(6) Were any formations sealed against pollution?

yes, no.

If YES depth of formation

Why

Drillers Remarks:

Description & Color of Materials Sand, Clay, Red Clay, Shell, etc.

Thickness Feet

Depth Feet

Clay

10

10

Sand

25

35

Clay

55

90

Sand & gravel

30

120

Clay


150

270

Sand

19

289

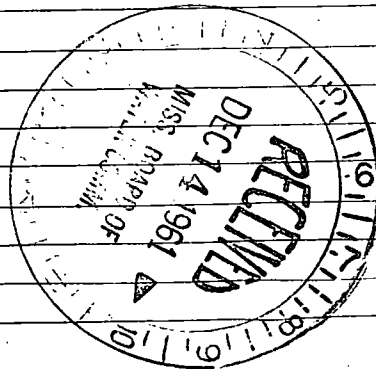

(Use Back Side)

Well No.

10-30

10-30

