

K2987

9-12-62

WATER WELL DRILLERS LOG

M
Hancock


Date: Sept 12, 1962, Driller: Max B. Drilling Co. County Hancock
(Name)

(1) Owner of Land: Lee Quality Homes
(Name)
Cullpat, Mass.
(Address)
(2) Location: Bay Side Park Subdivision
1/4, 1/4, Sec. 5 T. 2 R. 14
6 miles West of Bay St. Louis
(distance) (direction) (Nearest Town)
(3) Topography: Flat
(Hilly) (Flat) (Level)
(4) Purpose of Well: Domestic Home
(Domestic Irrigation
Municipal, Industrial, Other)

Description & Color of Materials Sand, Clay, Red Clay, Shell, etc.	Thick- ness Feet	Depth Feet
Clay	10	10
White Sand	20	30
White Clay	50	80
White Sand	20	100
White Clay	30	130
White Sand & Gravel	47	177
Blue Clay	177 on	

Information upon completion of well:
 63 FT - 2" Balance 1 1/2
 (1) Diameter 2 1/2 inches.
 (2) Total Depth 173 feet.
 (3) Water Level 6 feet below top of ground.
 (4) Cased to 168, Size 2" X 1 1/2"
 (5) Screen: Size 2" X 3/16", Length 5 FT.
 (6) Were any formations sealed against pollution?
 _____ yes, _____ no.

If YES depth of formation _____
 Why _____
 Drillers Remarks: _____

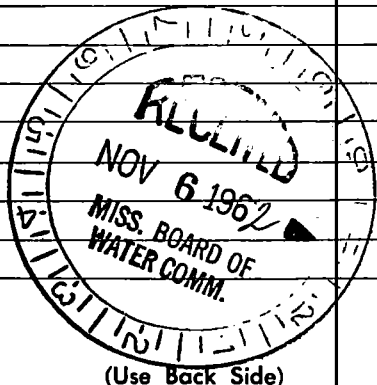

Well No.

