

K 2992
6-3-63

WATER WELL DRILLERS LOG

K

Date: 6-3, 1963, Driller: Sutton Well Works County Hancock
(Name)

(1) Owner of Land: Rev. R S Buck
(Name)
Waveland Miss.
(Address)

(2) Location: 1/4, 1/4, Sec. 4 T 9 S R 14 W
1/4 miles IN, of Waveland
(distance) (direction) (Nearest Town)

(3) Topography: flat
(Hilly) (Flat) (Level)

(4) Purpose of Well: domestic home
(Domestic Irrigation
Municipal, Industrial, Other)

Description & Color of Materials Sand, Clay, Red Clay, Shell, etc.	Thick- ness Feet	Depth Feet
<u>clay</u>	<u>10</u>	<u>10</u>
<u>sand</u>	<u>25</u>	<u>35</u>
<u>clay</u>	<u>121</u>	<u>156</u>
<u>sand</u>	<u>18</u>	<u>174</u>

Information upon completion of well:

(1) Diameter 2 inches.

(2) Total Depth 174 feet.

(3) Water Level 8 feet below top of ground.

(4) Cased to 169 all, Size 2"


(5) Screen: Size 2", Length 5'

(6) Were any formations sealed against pollution?
no yes, no.

If YES depth of formation _____

Why _____

Drillers Remarks: _____

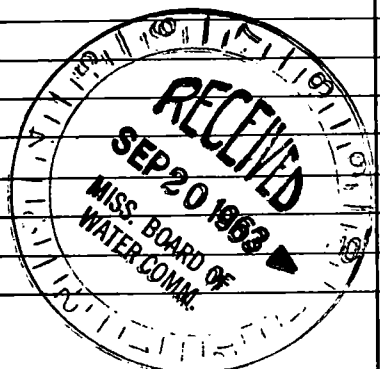

(Use Back Side)

Well No.

12

8

...

...

