

HANCOCK MISSISSIPPI BOARD OF WATER COMMISSIONERS

K2995

7-20-62

WATER WELL DRILLERS LOG

(?)

Date: 7-20, 1962, Driller: C. T. SWITZER WELL CO. County: Hancock

(Name)

(1) Owner of Land: Ray Hadner
 (Name)
Clement Harbor, Miss.
 (Address)

(2) Location: 17 95 14 18 T 5 R 14
 (distance) (direction) (Nearest Town)

(3) Topography: (Hilly) (Flat) (Level)

(4) Purpose of Well: Domestic Home
 (Domestic Irrigation
 Municipal, Industrial, Other)

Description & Color of Materials Sand, Clay, Red Clay, Shell, etc.	Thick- ness Feet	Depth Feet
Clay	00	12
Sand	12	64
Clay	64	97
Sand	97	120
Clay	120	146
Clay & sand str	146	166
Sand	166	181
Clay	181	246
Shell	246	266
Clay & shell	266	284
Sand	284	352
Clay	352	382
Sand str	382	407
Clay	407	417
Sand	417	457
Clay	457	504
Clay & shell	504	524
Clay	524	567
Clay & shell	567	588
Clay	588	598
Sand	598	609
Clay	609	681
Sand	681	710
Clay & sand str	710	730
Sand	730	835

Information upon completion of well:

(1) Diameter 3 inches.

(2) Total Depth 835 feet.

(3) Water level 24' feet below top of ground.


(4) Cased to 835', Size 3"

(5) Screen: Size 3", Length _____

(6) Were any formations sealed against pollution?
 yes, no.

If YES depth of formation _____
 Why Health Dept. Requirement

Drillers Remarks: _____

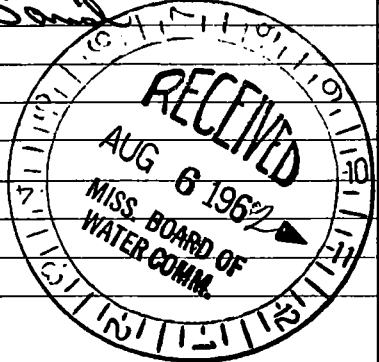

(Use Back Side)

Well No.

1864

I have the honor to acknowledge the receipt of your letter of the 11th inst. in relation to the above named matter. I have the pleasure to inform you that the same has been forwarded to the proper authorities for their consideration. I am, Sir, very respectfully,
 Yours truly,
 J. M. [Name]

J. M. [Name]