

HANCOCK MISSISSIPPI BOARD OF WATER COMMISSIONERS

~~N 2013~~ K2998

K

WATER WELL DRILLERS LOG

9-R-63

Date: 9-18, 1963, Driller: Sutton Well Works County Hancock  
(Name)

(1) Owner of Land: E. J. Aluvernay  
(Name)  
Waveland Miss.  
(Address)

(2) Location: SW 1/4, NW 1/4, Sec. 3 T9S R14 W  
1 miles N of Waveland  
(distance) (direction) (Nearest Town)

(3) Topography: flat  
(Hilly) (Flat) (Level)

(4) Purpose of Well: domestic home  
(Domestic Irrigation  
Municipal, Industrial, Other)

Description & Color of Materials Sand, Clay, Red Clay, Shell, etc.	Thick- ness Feet	Depth Feet
<u>Clay</u>	<u>7</u>	<u>7</u>
<u>sand</u>	<u>54</u>	<u>61</u>
<u>Clay</u>	<u>41</u>	<u>102</u>
<u>sand</u>	<u>71</u>	<u>173</u>

Information upon completion of well:

(1) Diameter 2 inches.

(2) Total Depth 173 feet.

(3) Water Level 10 feet below top of ground.

(4) Cased to 168, Size 2"


(5) Screen: Size 2", Length 5'

(6) Were any formations sealed against pollution?  
no yes,  no.

If YES depth of formation \_\_\_\_\_

Why \_\_\_\_\_

Drillers Remarks: \_\_\_\_\_

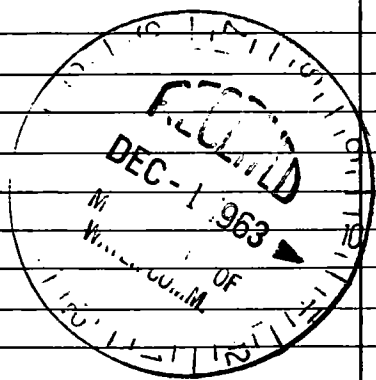

(Use Back Side)

Well No.

Account of the ...

10  
11  
12  
13  
14  
15

16  
17  
18  
19  
20

... of ...

... of ...

Internal

...

...

...

...