

~~A 2077~~ K 3002

WATER WELL DRILLERS LOG

H5  
K

2-28-64

Date: 2-28, 1964, Driller: Sutter Well Works County Hancock  
(Name)

(1) Owner of Land: Geo. Schroeder  
(Name)  
Waveland, Miss.  
(Address)

(2) Location: NW 1/4, SE 1/4, Sec. 4 T9S R14E  
1 miles N of Waveland  
(distance) (direction) (Nearest Town)

(3) Topography: flat  
(Hilly) (Flat) (Level)

(4) Purpose of Well: domestic home  
(Domestic Irrigation  
Municipal, Industrial, Other)

Description & Color of Materials Sand, Clay, Red Clay, Shell, etc.	Thick- ness Feet	Depth Feet
<u>Clay</u>	<u>16</u>	<u>16</u>
<u>Sand &amp; Mud</u>	<u>52</u>	<u>68</u>
<u>Clay - Sand streaks</u>	<u>78</u>	<u>146</u>
<u>Sand - gravel</u>	<u>28</u>	<u>174</u>

Information upon completion of well:

(1) Diameter 2 inches.

(2) Total Depth 174 feet.

(3) Water Level 8 feet below top of ground.  
169

(4) Cased to 260, Size 2"


(5) Screen: Size 2", Length 5'

(6) Were any formations sealed against pollution?  
yes,  no.

If YES depth of formation \_\_\_\_\_

Why \_\_\_\_\_

Drillers Remarks: \_\_\_\_\_

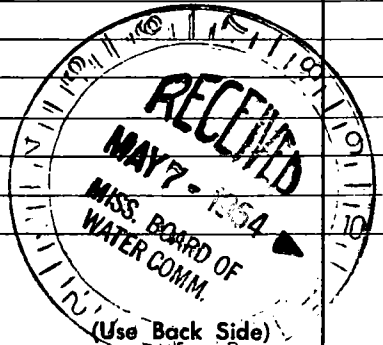

Well No.

Handwritten text at the top of the page, possibly a title or header.

Handwritten notes on the left side of the page, including some numbers and possibly names.

Handwritten notes on the right side of the page, continuing the text or providing additional information.

Handwritten notes in the middle section of the page, possibly describing a process or method.

Handwritten notes in the lower middle section of the page, continuing the narrative or list.

Handwritten notes at the bottom of the page, possibly concluding the document or providing a summary.