

HANCOCK MISSISSIPPI BOARD OF WATER COMMISSIONERS

~~2019~~ K3004

6-8-64

WATER WELL DRILLERS LOG

K

Date: June 8, 1964, Driller: Sutter Well Works County Hancock

(Name)

(1) Owner of Land: R.E. Stepp
 (Name)
1313 Springhill Ave - Mobile, Ala.
 (Address)

(2) Location: 1/4, 1/4, Sec. 4 T8SR 14W
_____ miles _____ IN _____ of Wauwautaw
 (distance) (direction) (Nearest Town)

(3) Topography: flat
 (Hilly) (Flat) (Level)

(4) Purpose of Well: domestic Home
 (Domestic Irrigation
 Municipal, Industrial, Other)

Description & Color of Materials Sand, Clay, Red Clay, Shell, etc.	Thick- ness Feet	Depth Feet
<u>clay</u>	<u>8</u>	<u>8</u>
<u>sand</u>	<u>34</u>	<u>42</u>
<u>clay</u>	<u>90</u>	<u>132</u>
<u>sand</u>	<u>46</u>	<u>178</u>

Information upon completion of well:

(1) Diameter 2 inches.

(2) Total Depth 178 feet.

(3) Water Level 7 feet below top of ground.

(4) Cased to 173, Size 2"


(5) Screen: Size 2", Length 5'

(6) Were any formations sealed against pollution?
 _____ yes, no.

If YES depth of formation _____

Why _____

Drillers Remarks: _____

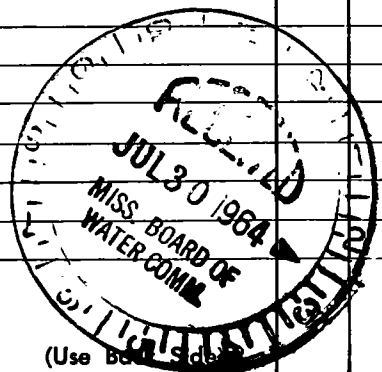

Well No.

(Use Board Seal)

Handwritten header or title at the top of the page, possibly including a date or reference number.

Main body of handwritten text, possibly a list or notes, located on the right side of the page.

801

7

700

3

7